
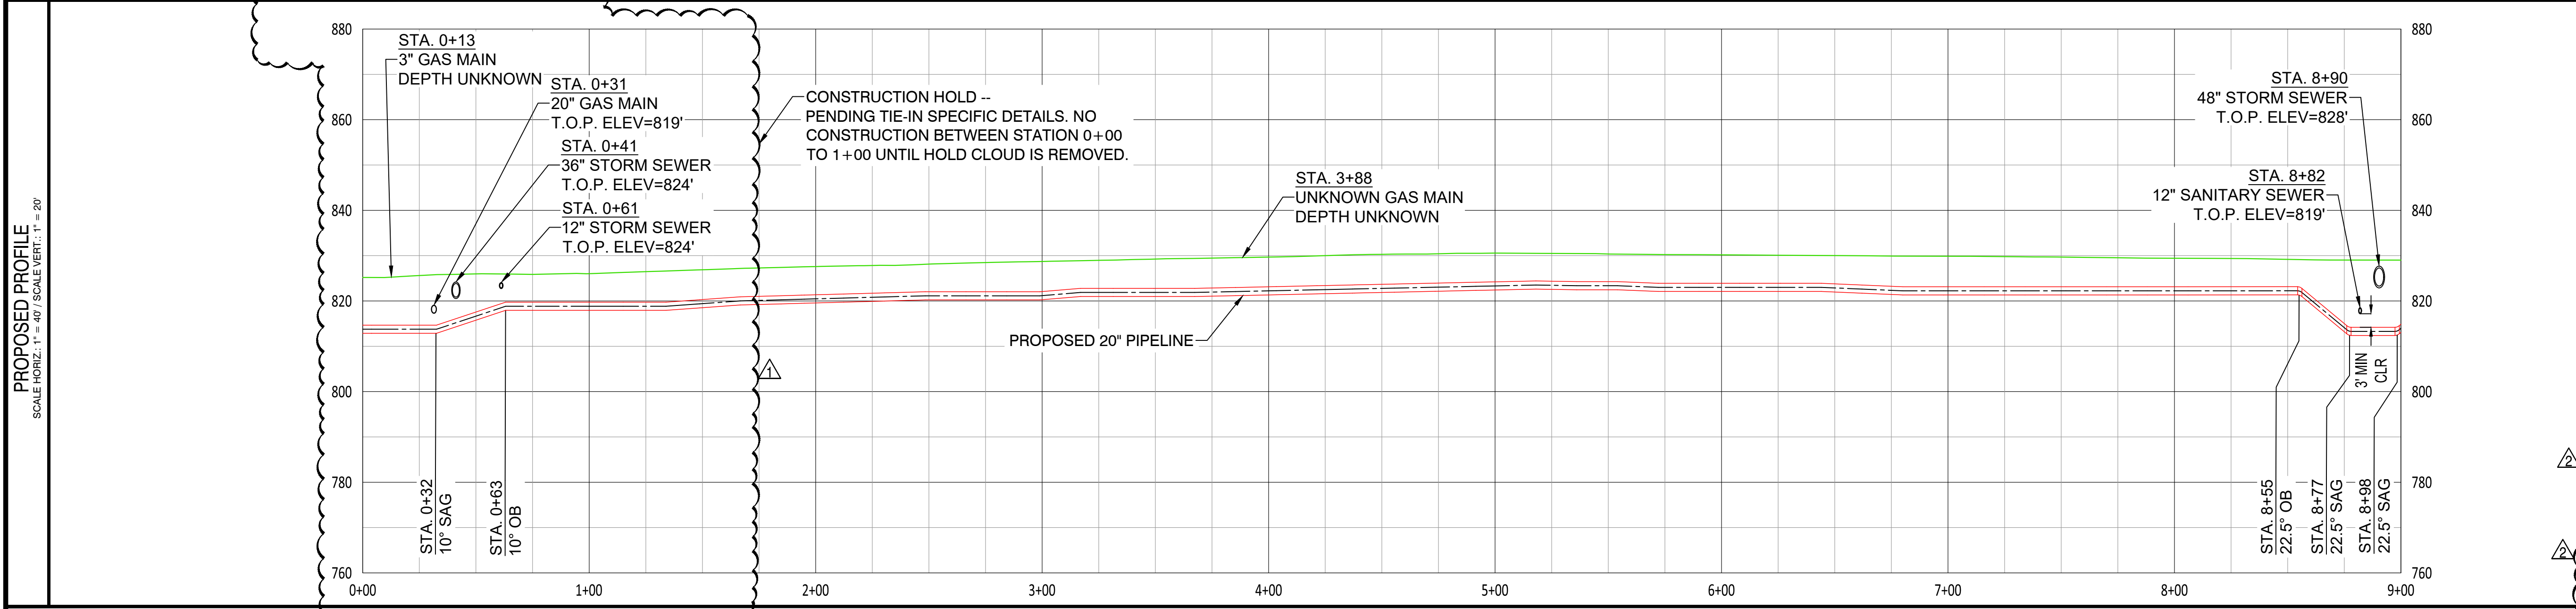


OWNERSHIP	CITY OF UPPER ARLINGTON
JURISDICTION / PARCEL ID	CITY OF UPPER ARLINGTON / FRANKLIN COUNTY
TEST PRESSURE / DESIGN INFO	1080 PSIG MIN / 1280 PSIG MAX / CLASS IV / 720 PSIG
CONSTRUCTION METHOD	OPEN CUT / OC-04
PIPE	⑤ - 90'
FITTINGS	②① ②② ②③

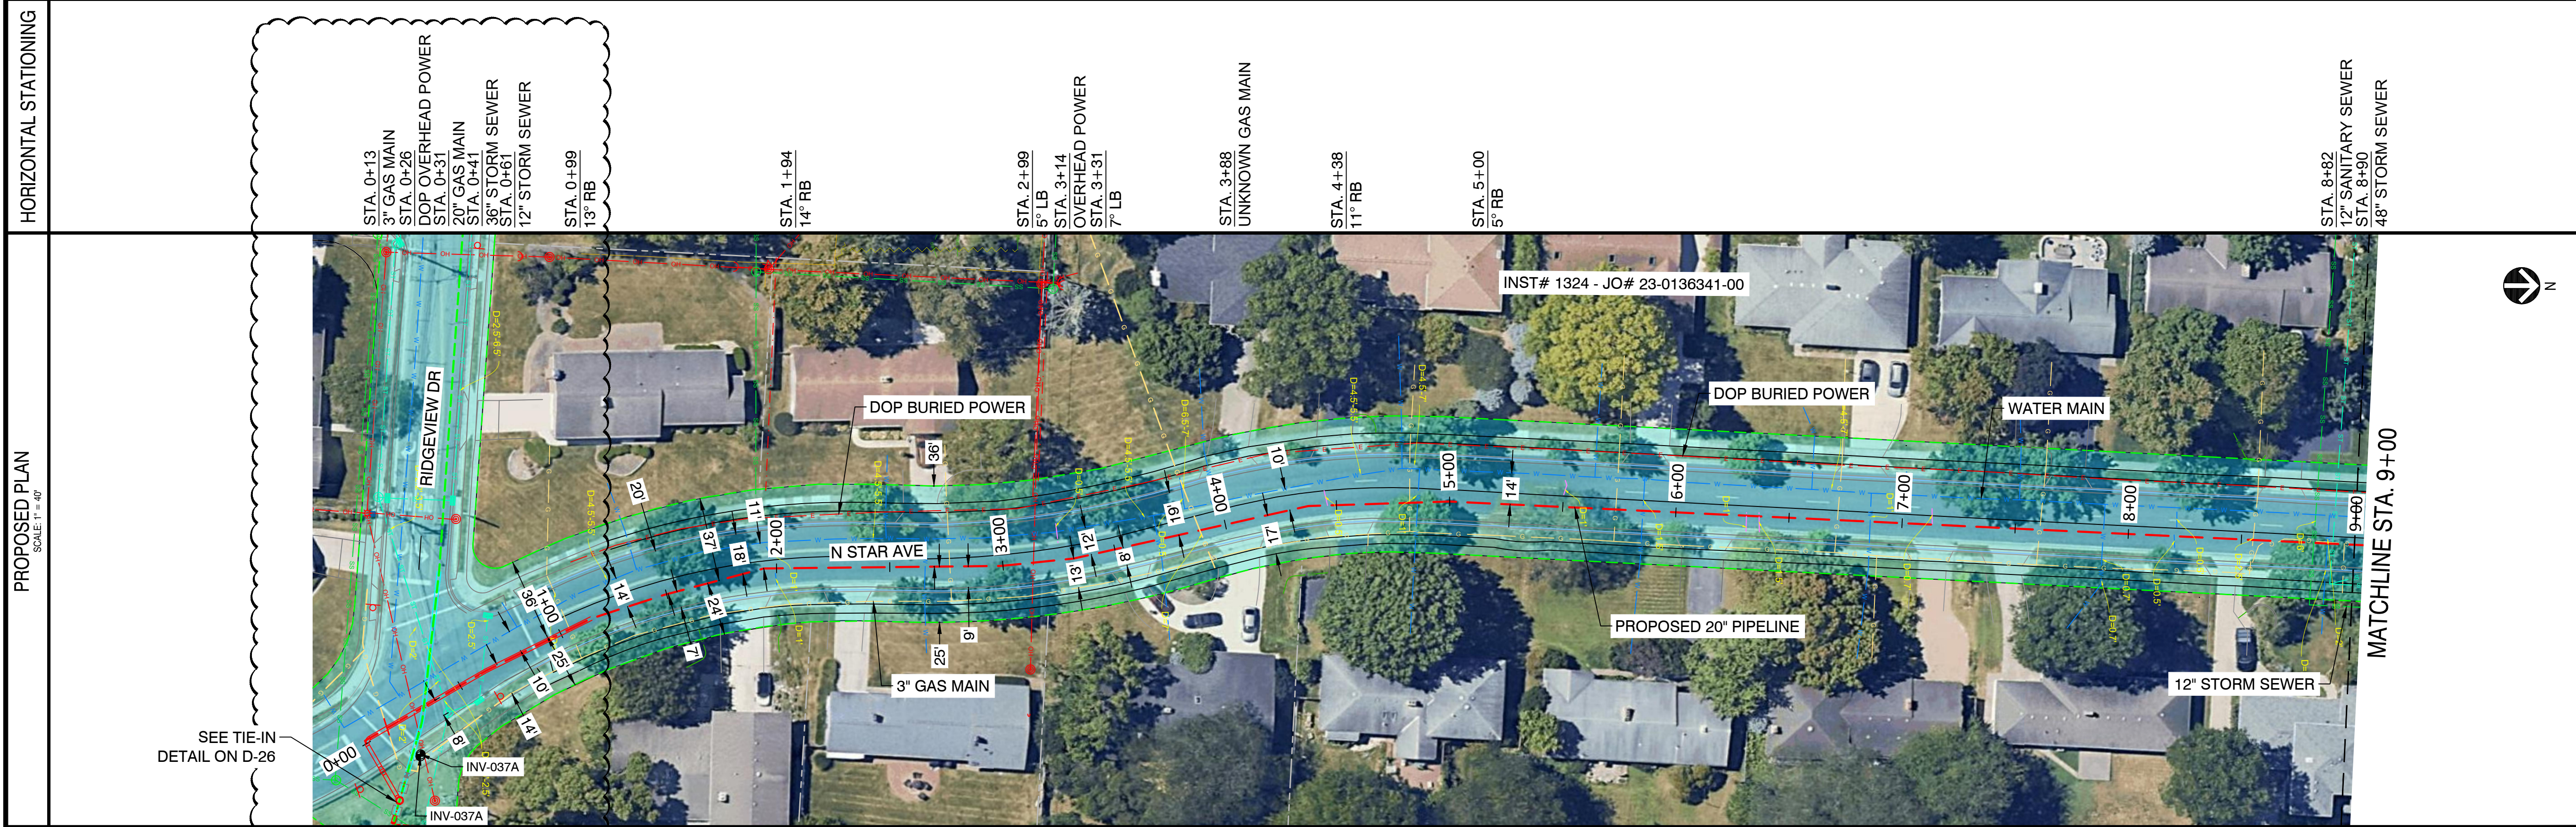

- NOTES:
- CONTRACTOR SHALL VERIFY ALL UTILITY CROSSINGS
 - SEE GENERAL NOTES FOR CLEARANCE REQUIREMENTS
 - SEE TD-01 FOR OPEN CUT DETAILS
 - SERVICE LINE CROSSINGS SHOWN IN SURVEY ARE NOT STATIONED OR SHOWN IN PROFILE FOR CLARITY
 - THE PIPELINE HAS GENERALLY BEEN DESIGNED WITH A COVER OF 6'-0" TO ACCOUNT FOR THE DEPTH OF UNKNOWN SERVICE LINES. MINIMUM ALLOWABLE DEPTH OF COVER IS 4'-0"
 - VERTICAL BENDS CALLED OUT IN PROFILE ARE FOR REFERENCE. CONTRACTOR TO MAKE USE OF ROPING AND FIELD BENDS WHERE POSSIBLE. REFER TO GS 3010.030 FOR FURTHER DETAILS
 - CORROSION PROTECTION IS DESIGNED BY NISOURCE AND IS NOT COVERED WITHIN THE ENGINEER'S STAMP
 - AERIAL IMAGERY IS FOR REFERENCE ONLY
 - FITTING EXTENTS SHOWN IN THE PROFILE ARE FOR REFERENCE ONLY. REFER TO STATIONING BAND FOR LOCATIONS OF ANTICIPATED FITTINGS. A 3X DIAMETER OF STRAIGHT PIPE IS REQUIRED BETWEEN ALL FITTINGS. REFER TO GS 2110.020 FOR FURTHER DETAILS

Ohio Utilities Protection Service

Call 811

before you dig

401 N Front St, Suite 380, Columbus, OH 43215
(303) 623-3345

PROPOSED

REVISIONS			
REV. #	DATE	DESCRIPTION	
1	06/04/25	REVISED FOR FUTURE TIE-IN	
0	11/26/24	ISSUED FOR PERMIT	

DESIGNED BY	EK	05/31/23	614-981-0661
DRAWN BY	JEM	05/31/23	855-266-7671
CHECKED BY	JMJ	05/31/23	855-226-7671
AS-BUILT BY	TBD	TBD	TBD
	NAME	DATE	PHONE #

SITE NAME:

INST# 23-0136341-00
ABAN# 23-0136342-00
INST# 24-0136890-00
ABAN# 24-0136891-00
PROJECT ID# 21-78791

NCHP PIPELINE REPLACEMENT, WEST CENTRAL
UPPER ARLINGTON/ COLUMBUS, FRANKLIN COUNTY, OH

DRAWING TITLE:

20" RIDGEVIEW TO DEFAANCE ALIGNMENT
STA. 0+00 TO STA. 9+00

DRAWING NO:

L-2014