



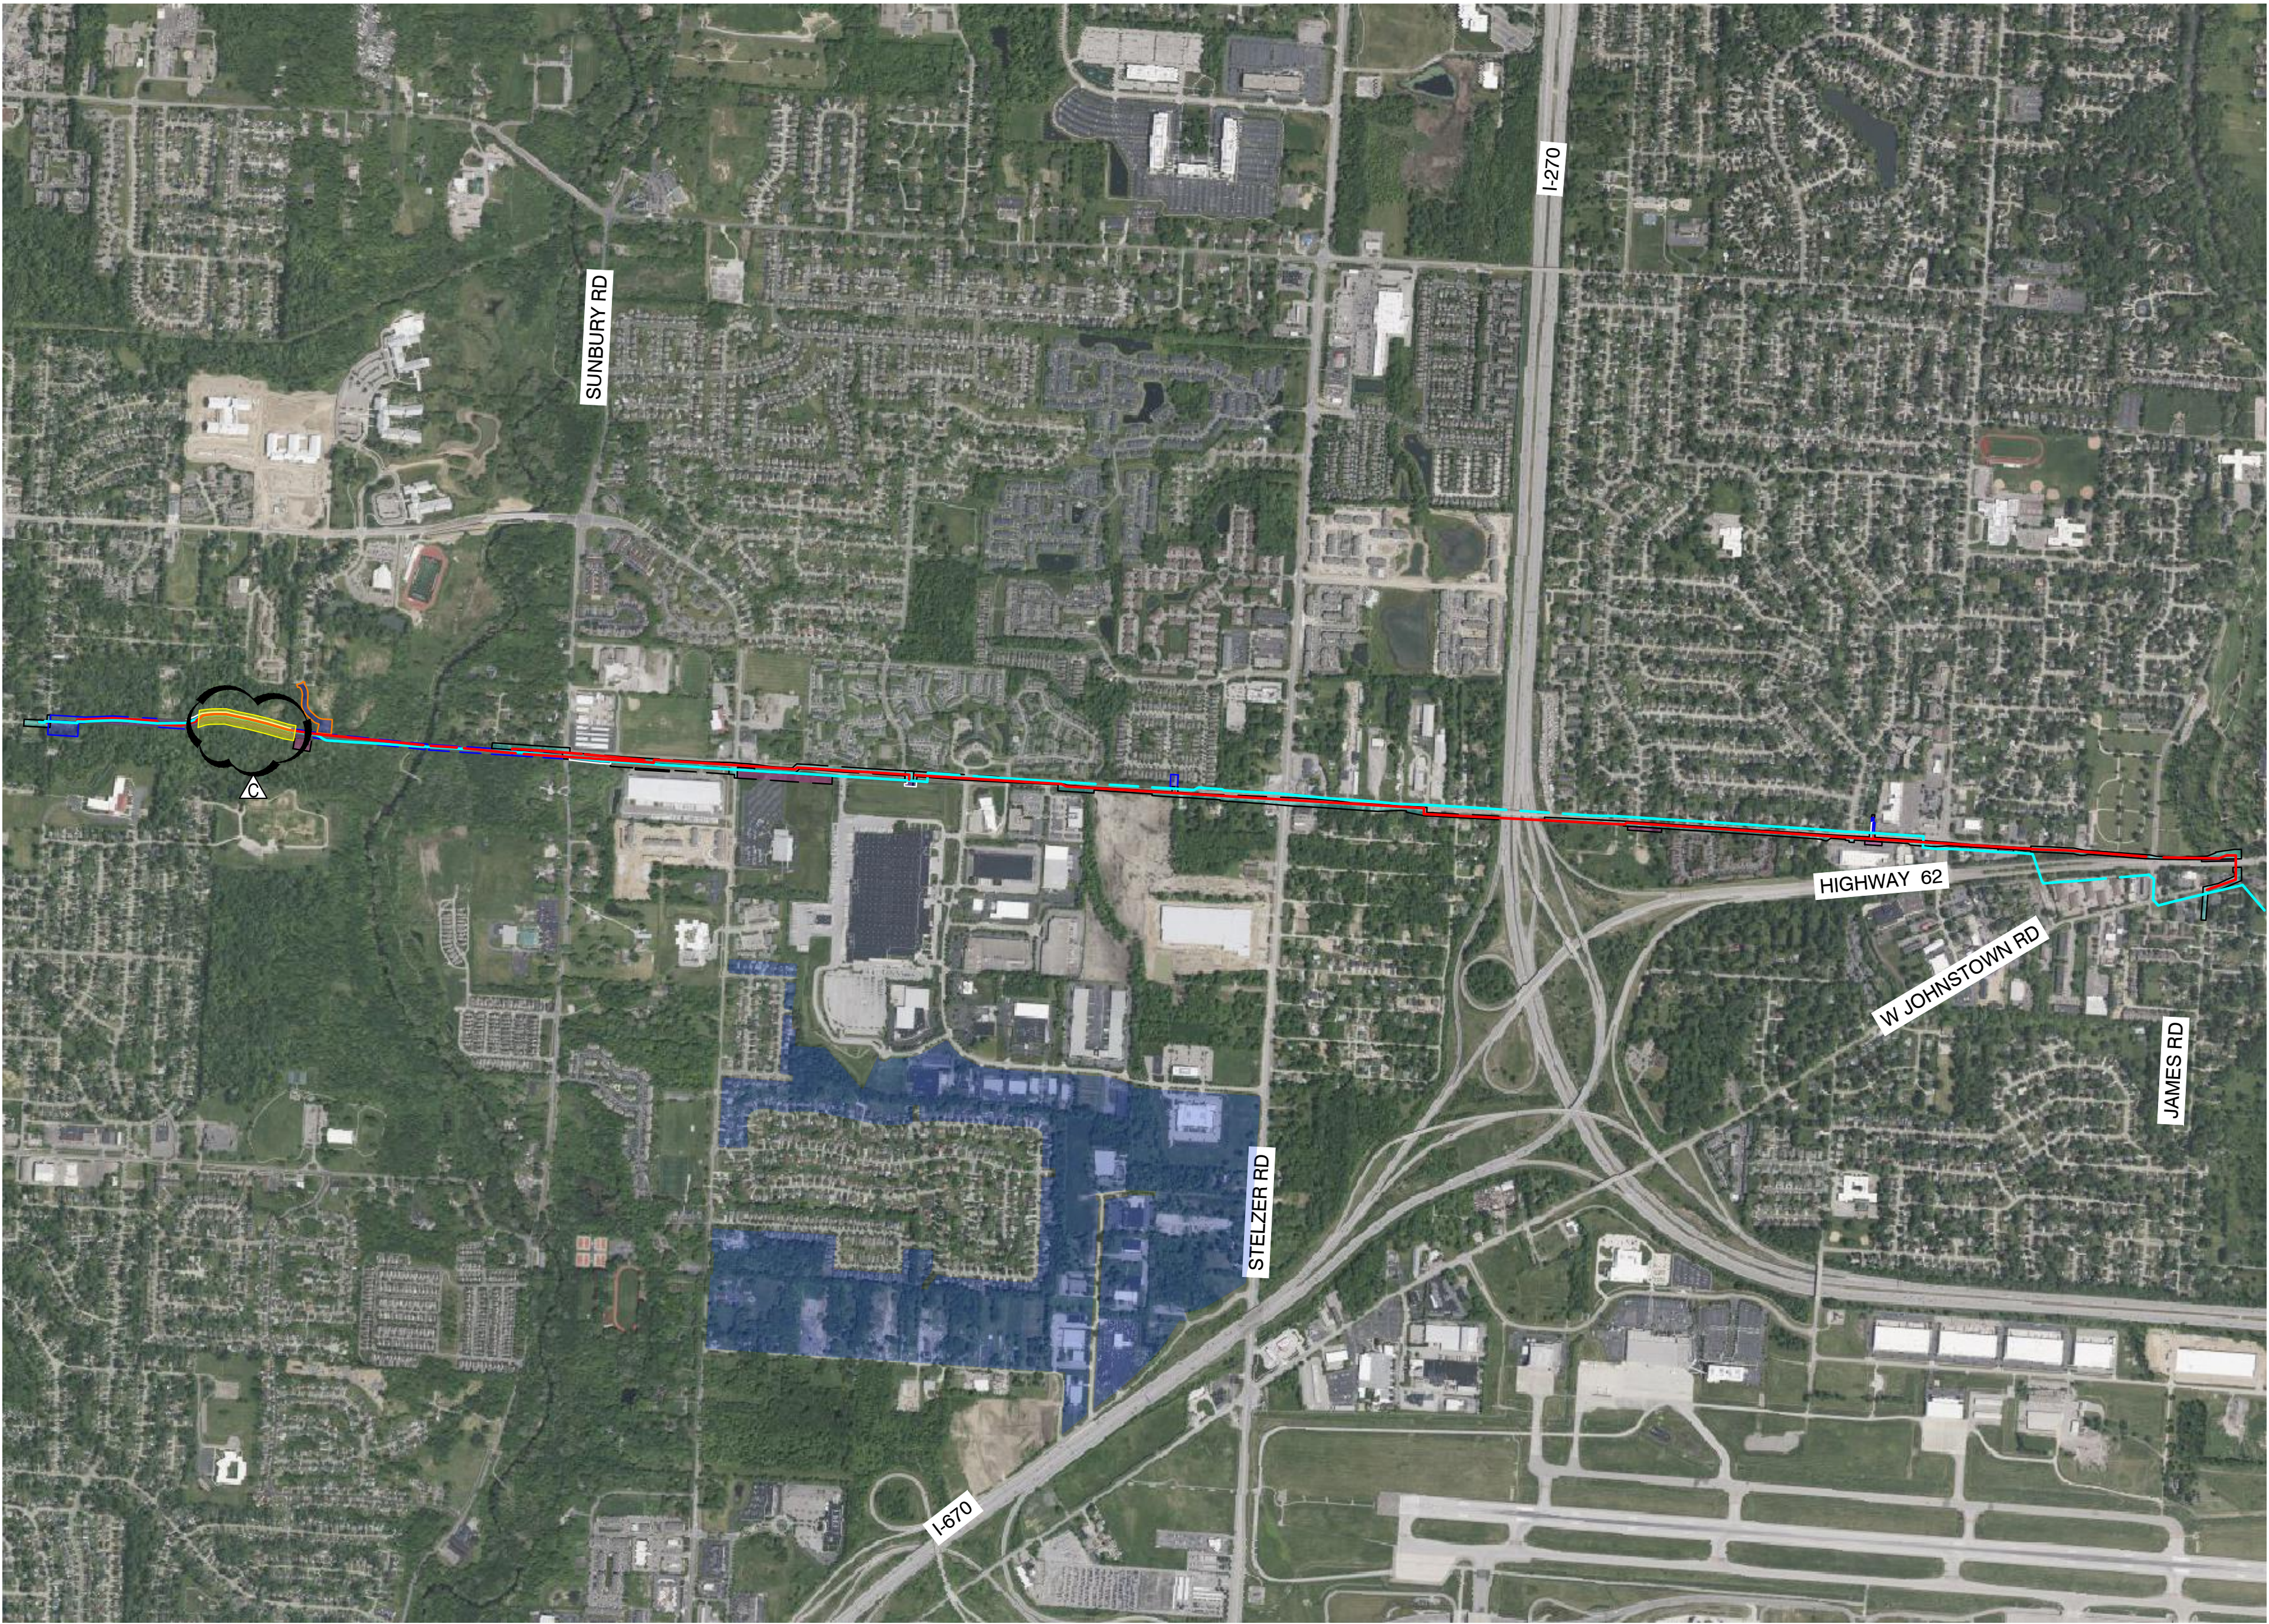

OVERVIEW SHEET INDEX
SCALE: 1"=1000'

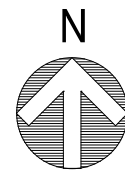

PROPOSED

REVISIONS			
C	07/03/25	REVISED FOR ALIGNMENT SHIFT	
B	05/05/25	REVISED FOR CONSTRUCTION NOTICE	
A	12/23/24	ISSUED FOR PERMIT	
REV. #	DATE	DESCRIPTION	
INTERNAL ENG.	AD	12/23/24	614-981-0661
DESIGNED BY	JMJ	12/23/24	855-266-7671
CHECKED BY	RBW	12/23/24	855-266-7671
AS-BUILT BY	TBD	TBD	TBD
		NAME	PHONE #

SITE NAME:
INST# 23-0083895-00
ABAN# 23-0083897-00
PROJECT ID# 21-78793
AGLER ROAD NCHP PIPELINE PROJECT
COLUMBUS/GAHANNA, FRANKLIN COUNTY, OH

DRAWING TITLE:
OVERVIEW WORKSPACE

DRAWING NO:
AG-01



INSTALLATION ORDER NUMBER 23-0083895-00

ABANDONMENT ORDER NUMBER 23-0083897-00

PROJECT ID 21-78793


AGLER ROAD NCHP PIPELINE PROJECT

JOB TYPE: MAINS-LEAKAGE ELIMINATION (557/558)

PROJECT INFORMATION

DESIGN ENGINEER	ANTHONY D'EGIDIO
FIELD ENGINEER/TECHNICIAN	KAITLIN DYGERT
CONSTRUCTION FFL:	MATTHEW ALIFF
PERMITS	CITY OF COLUMBUS PERMIT
	CITY OF GAHANNA PERMIT
	FRANKLIN COUNTY PERMIT
	ENVIRONMENTAL PERMITS
	DOT PERMITS
	OPSB PERMIT
	0823/COLUMBUS NORTHEAST
TCC/LOA	FRANKLIN COUNTY, OH
COUNTY	0250150
TASK DISTRICT/TOWNSHIP ID	0250530
	0250040
	0250010
	0250520
MAP/GRID NUMBER	7336428A
	7336428B
	7336428C
	7336428D
	7332428A
	7332428B
24 HR. EMERGENCY LINE	1-800-344-4077

VICINITY MAP

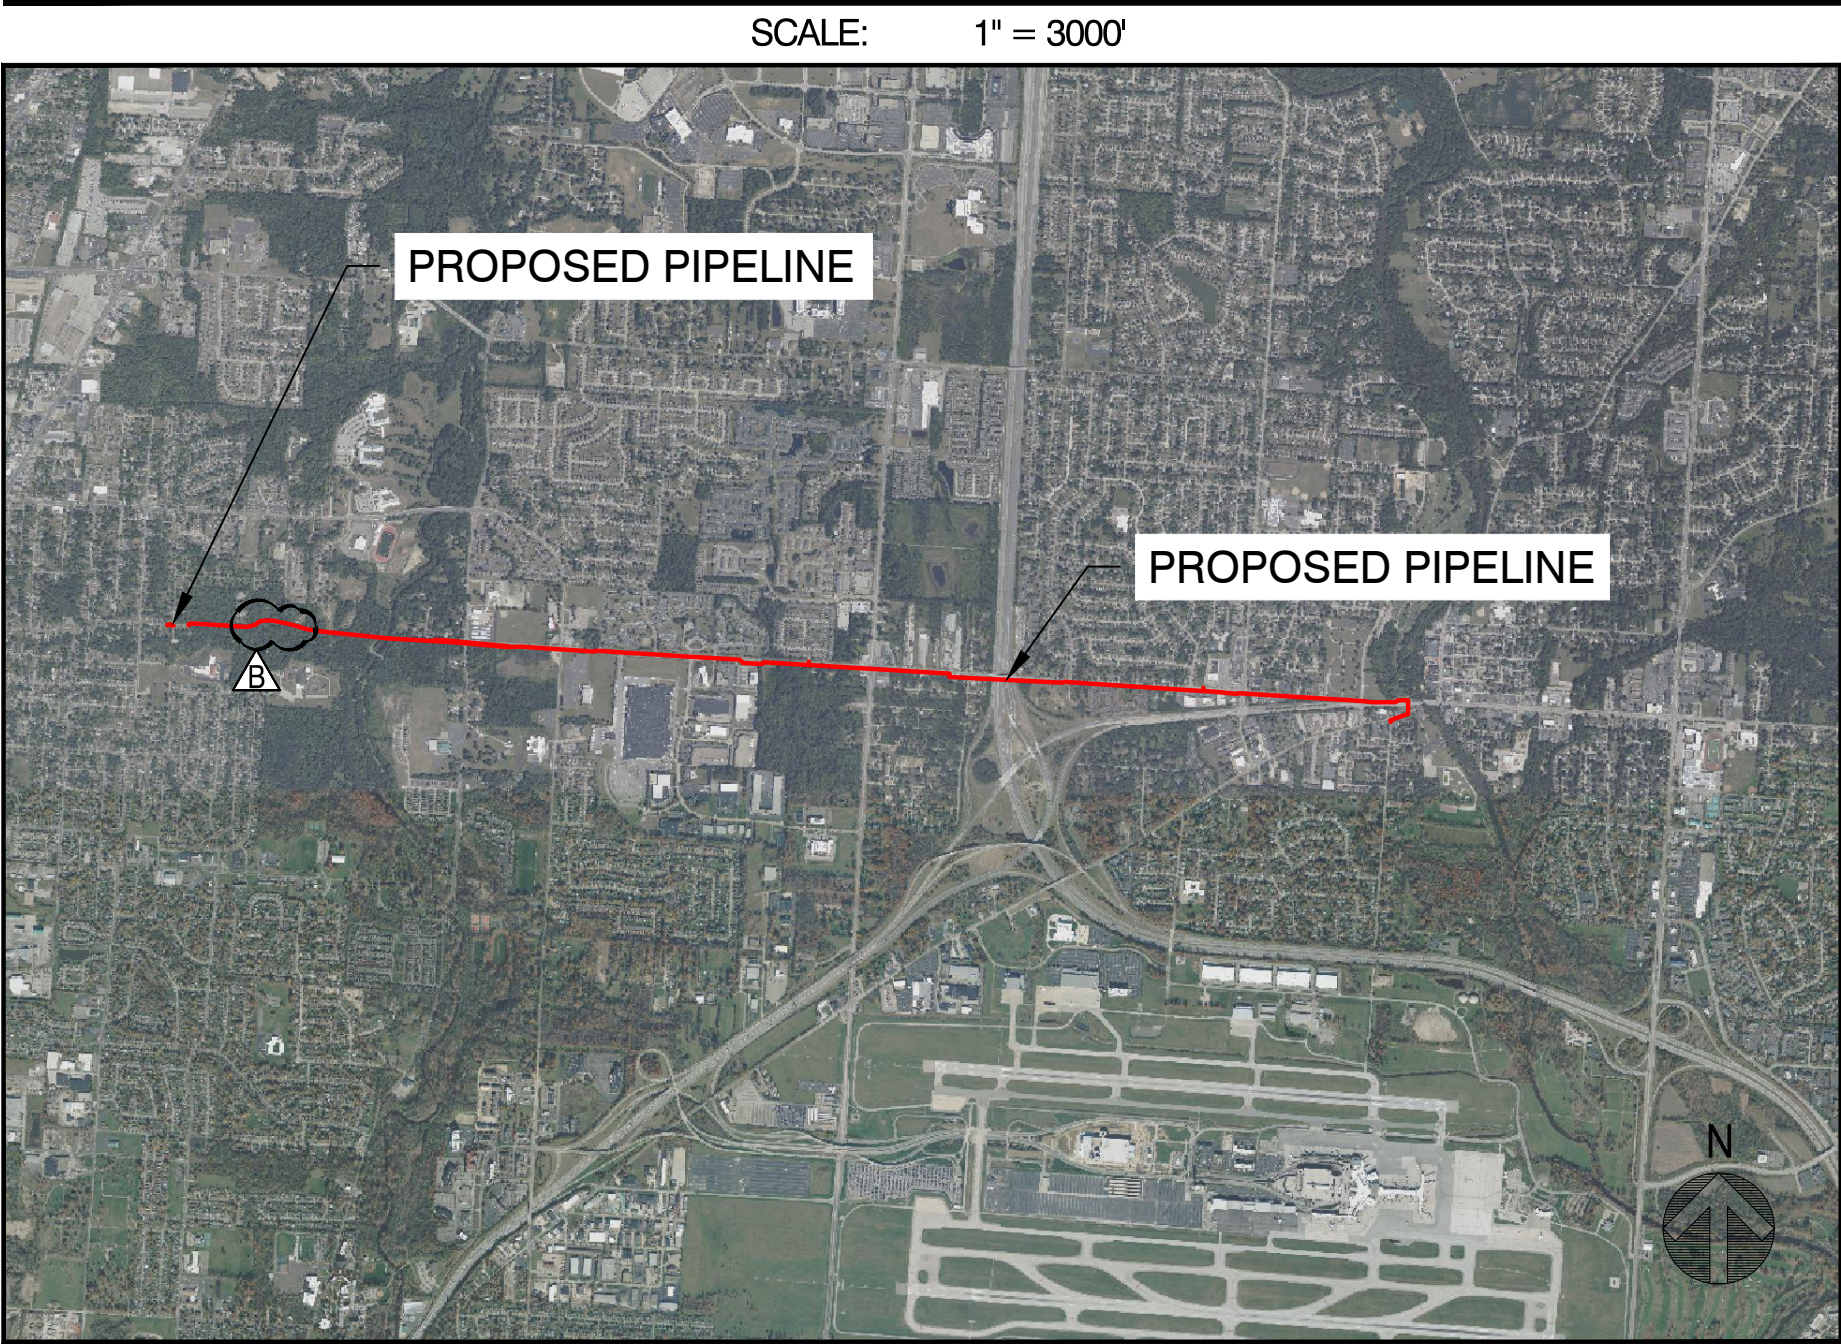

PROJECT DESCRIPTION

INSTALLATION OF 3.8 MILES OF 24-INCH HIGH PRESSURE STEEL PIPELINE

SHEET INDEX

DWG.	DESCRIPTION
T-2001 - T-2002	TITLE SHEET AND INDEX SHEET
GN-2001 - GN-2002	GENERAL NOTES
O-2001	OVERVIEW SHEET
L-2001 - L-2021	ALIGNMENT SHEETS



401 N Front St, Suite 380, Columbus, OH 43215
(380) 799-8503

PROPOSED

REVISIONS

B	07/03/25	REVISED FOR ALIGNMENT SHIFT
A	12/23/24	ISSUED FOR PERMIT

REV. #	DATE	DESCRIPTION
INTERNAL ENG.	AD	12/23/24 614-981-0661
DESIGNED BY	JMJ	12/23/24 855-266-7671
CHECKED BY	RBW	12/23/24 855-266-7671
AS-BUILT BY	TBD	TBD
	NAME	DATE PHONE #

SITE NAME:

INST# 23-0083895-00
ABAN# 23-0083897-00
PROJECT ID# 21-78793
AGLER ROAD NCHP PIPELINE PROJECT
COLUMBUS/GAHANNA, FRANKLIN COUNTY, OH

DRAWING TITLE:

TITLE SHEET

DRAWING NO:

T-2001



PROPOSED

REVISIONS

B	07/03/25	REVISED FOR ALIGNMENT SHIFT
A	12/23/24	ISSUED FOR PERMIT
REV. #	DATE	DESCRIPTION

INTERNAL ENG.	AD	12/23/24	614-981-0661
DESIGNED BY	JMJ	12/23/24	855-266-7671
CHECKED BY	RBW	12/23/24	855-266-7671
AS-BUILT BY	TBD	TBD	TBD
	NAME	DATE	PHONE #

SITE NAME:
INST# 23-0083895-00
ABAN# 23-0083897-00
PROJECT ID# 21-78793
AGLER ROAD NCHP PIPELINE PROJECT
COLUMBUS/GAHANNA, FRANKLIN COUNTY, OH



DRAWING TITLE:

INDEX SHEET

DRAWING NO:

T-2002

SHEET INDEX		
DWG.	DESCRIPTION	REV
GENERAL		
T-2001	TITLE SHEET	B
T-2002	INDEX SHEET	B
GN-2001	NISOURCE GENERAL NOTES	A
GN-2002	GENERAL NOTES AND LEGEND	A
ALIGNMENT SHEETS		
O-2001	OVERVIEW SHEET	C
L-2001	24" WEST LINDEN ALIGNMENT STA 0+00 TO STA 1+12	A
L-2002	STA 0+00 TO STA 10+00	B
L-2003	STA 10+00 TO STA 20+00	B
L-2004	STA 20+00 TO STA 30+00	B
L-2005	STA 30+00 TO STA 40+00	B
L-2006	STA 40+00 TO STA 50+00	B
L-2007	STA 50+00 TO STA 60+00	B
L-2008	STA 60+00 TO STA 70+00	A
L-2009	STA 70+00 TO STA 80+00	B
L-2010	STA 80+00 TO STA 90+00	A
L-2011	STA 90+00 TO STA 100+00	A
L-2012	STA 100+00 TO STA 110+00	A
L-2013	STA 110+00 TO STA 120+00	A
L-2014	STA 120+00 TO STA 130+00	A
L-2015	STA 130+00 TO STA 140+00	A
L-2016	STA 140+00 TO STA 150+00	A
L-2017	STA 150+00 TO STA 160+00	A
L-2018	STA 160+00 TO STA 170+00	A
L-2019	STA 170+00 TO STA 180+00	A
L-2020	STA 180+00 TO STA 190+00	A
L-2021	STA 190+00 TO STA 198+02	A

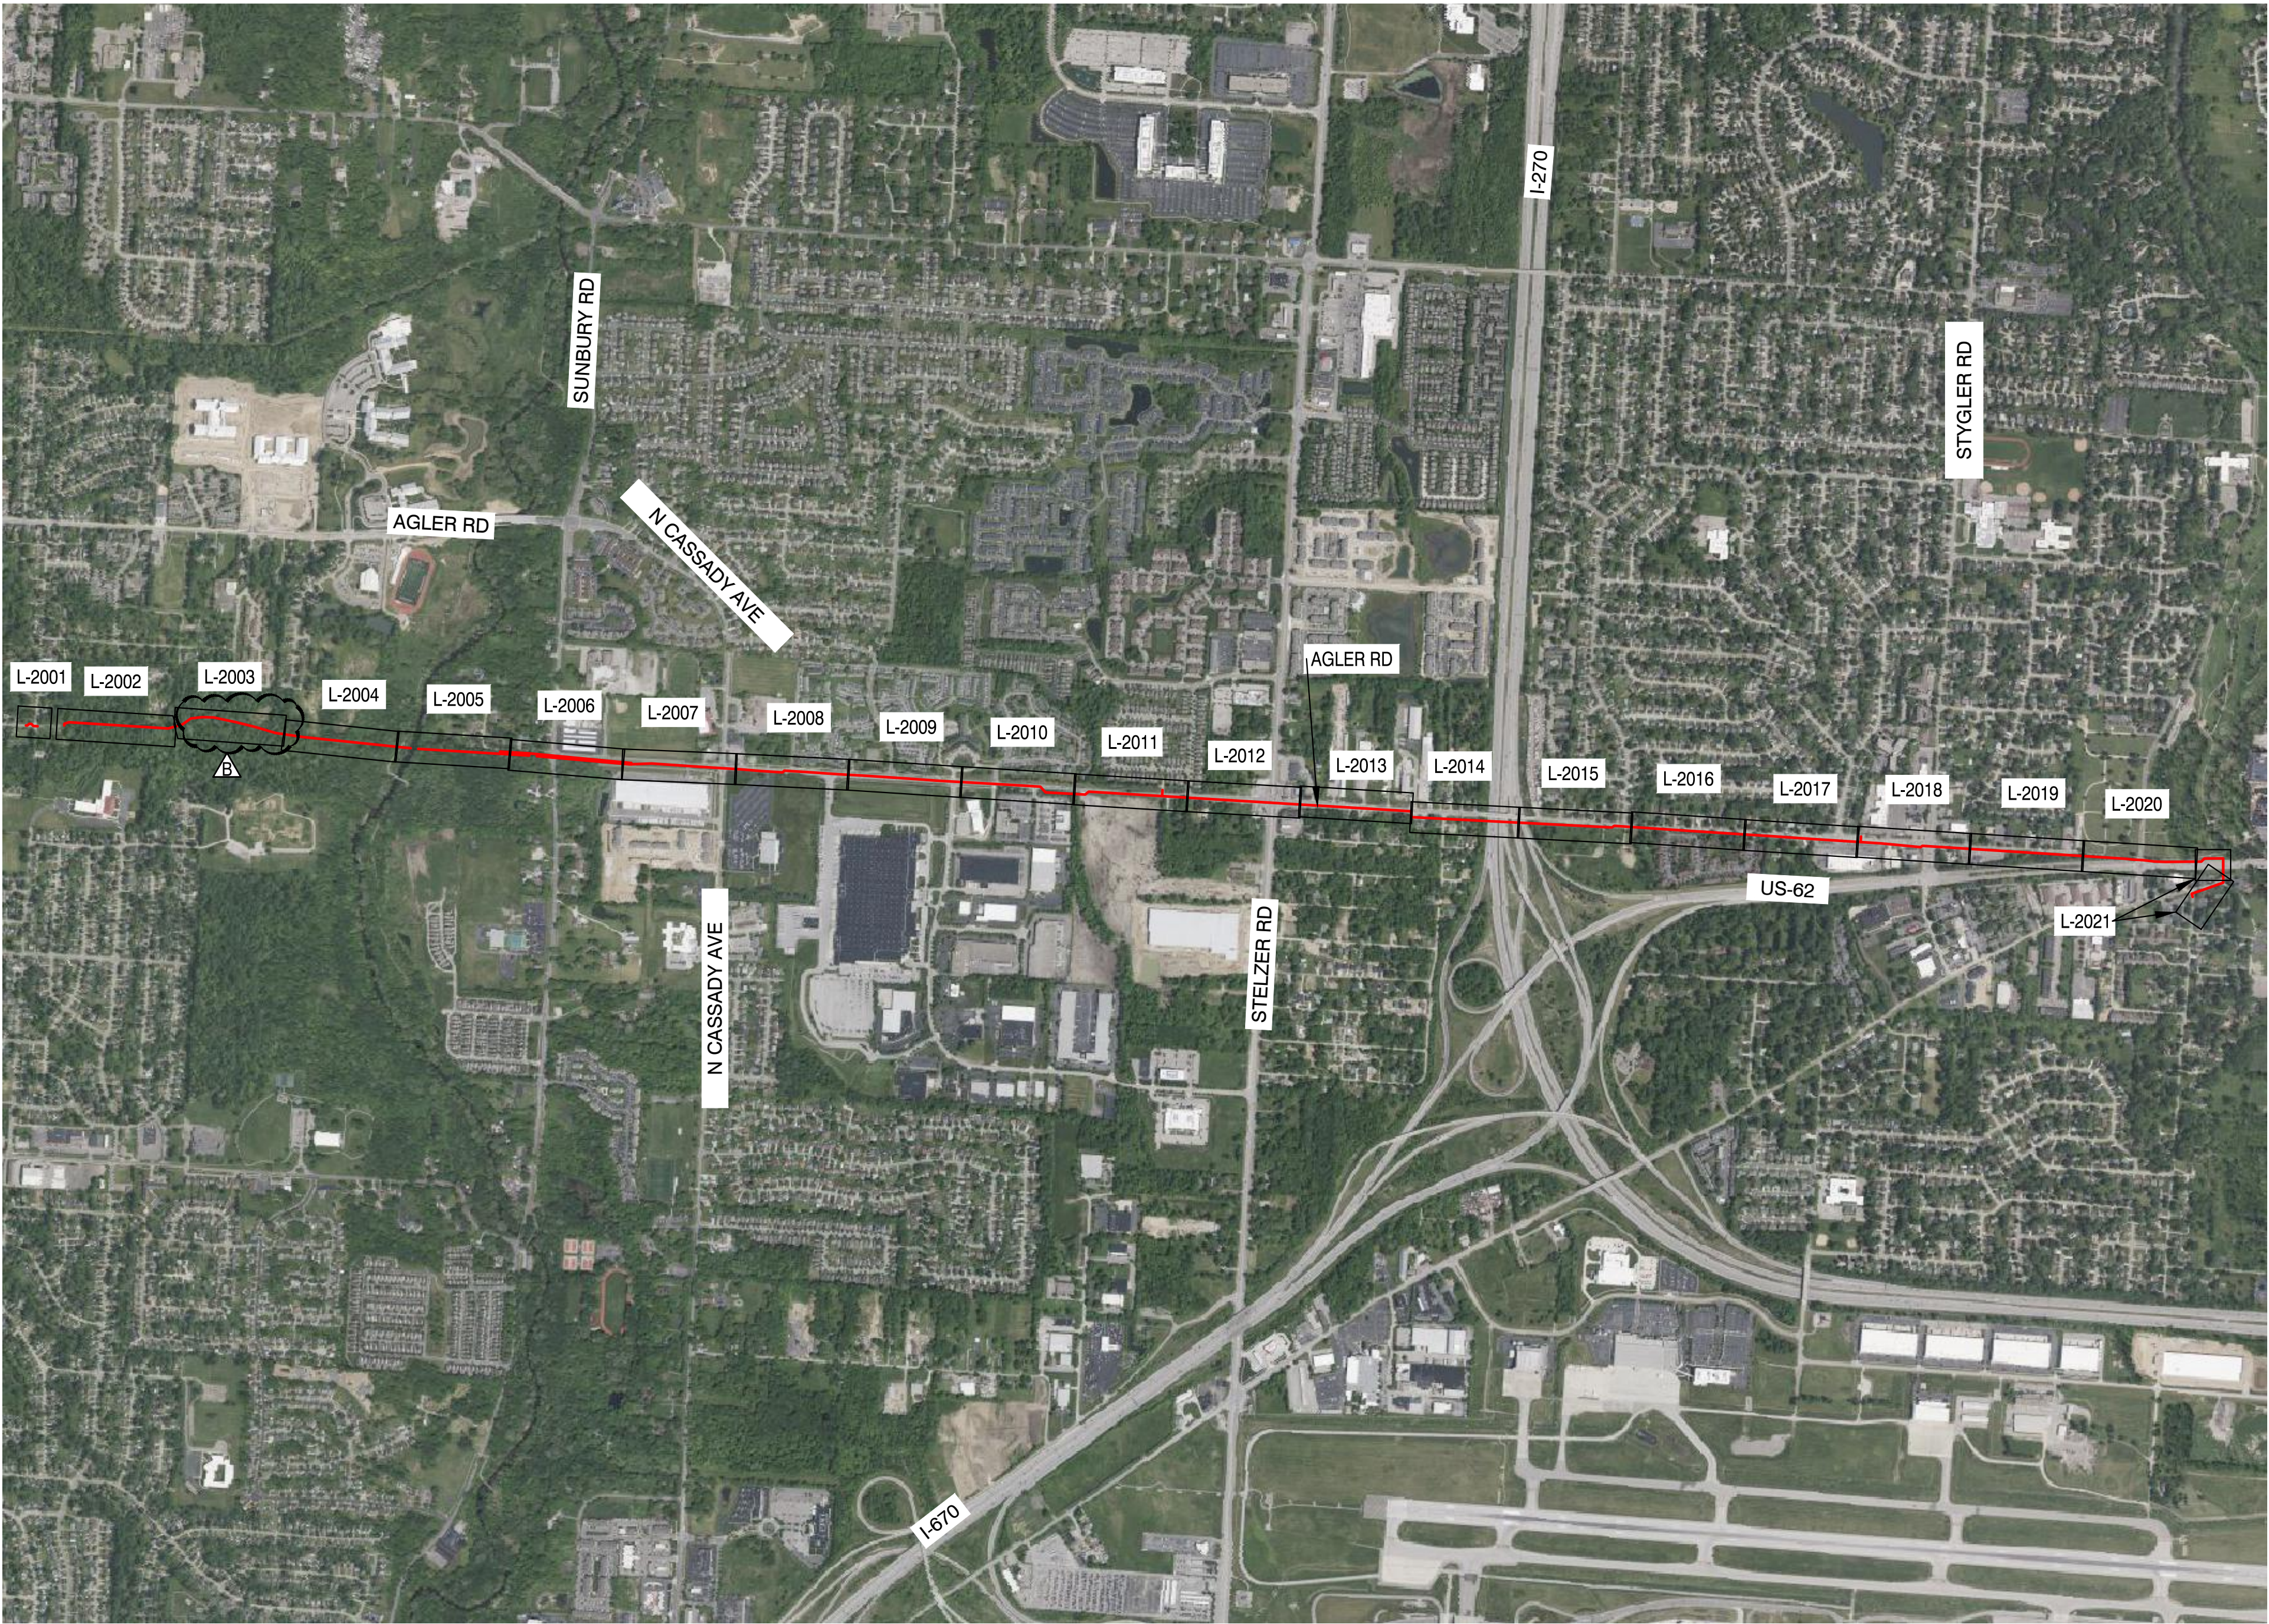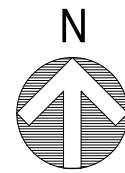

OVERVIEW SHEET INDEX
SCALE: 1"=1000'

NOTE:
1. AERIAL IMAGERY IS FOR REFERENCE ONLY.



Ohio Utilities Protection Service



401 N Front St, Suite 380, Columbus, OH 43215
(380) 799-8503

PROPOSED




REVISIONS			
B	07/03/25	REVISED FOR ALIGNMENT SHIFT	
A	12/23/24	ISSUED FOR PERMIT	
REV. #	DATE	DESCRIPTION	
INTERNAL ENG.	AD	12/23/24	614-981-0661
DESIGNED BY	JMJ	12/23/24	855-266-7667
CHECKED BY	RBW	12/23/24	855-266.7667
AS-BUILT BY	TBD	TBD	TBD
	NAME	DATE	PHONE #

SITE NAME:
INST# 23-0083895-00
ABAN# 23-0083897-00
PROJECT ID# 21-78793
AGLER ROAD NCHP PIPELINE PROJECT
COLUMBUS/GAHANNA, FRANKLIN COUNTY, OH

DRAWING TITLE:
OVERVIEW SHEET

DRAWING NO:
O-2001

OWNERSHIP	BRIDGEWALK BIRDIE LLC		BRIDGEWALK BIRDIE LLC	FAITH MINISTRIES INC
JURISDICTION / PARCEL ID	010-073672-00		010-073678-00	010-222988-00
TEST PRESSURE / DESIGN INFO	1080 PSIG MIN / 1280 PSIG MAX / CLASS IV / 720 PSIG			
CONSTRUCTION METHOD	OPEN CUT			
PIPE				
FITTINGS				

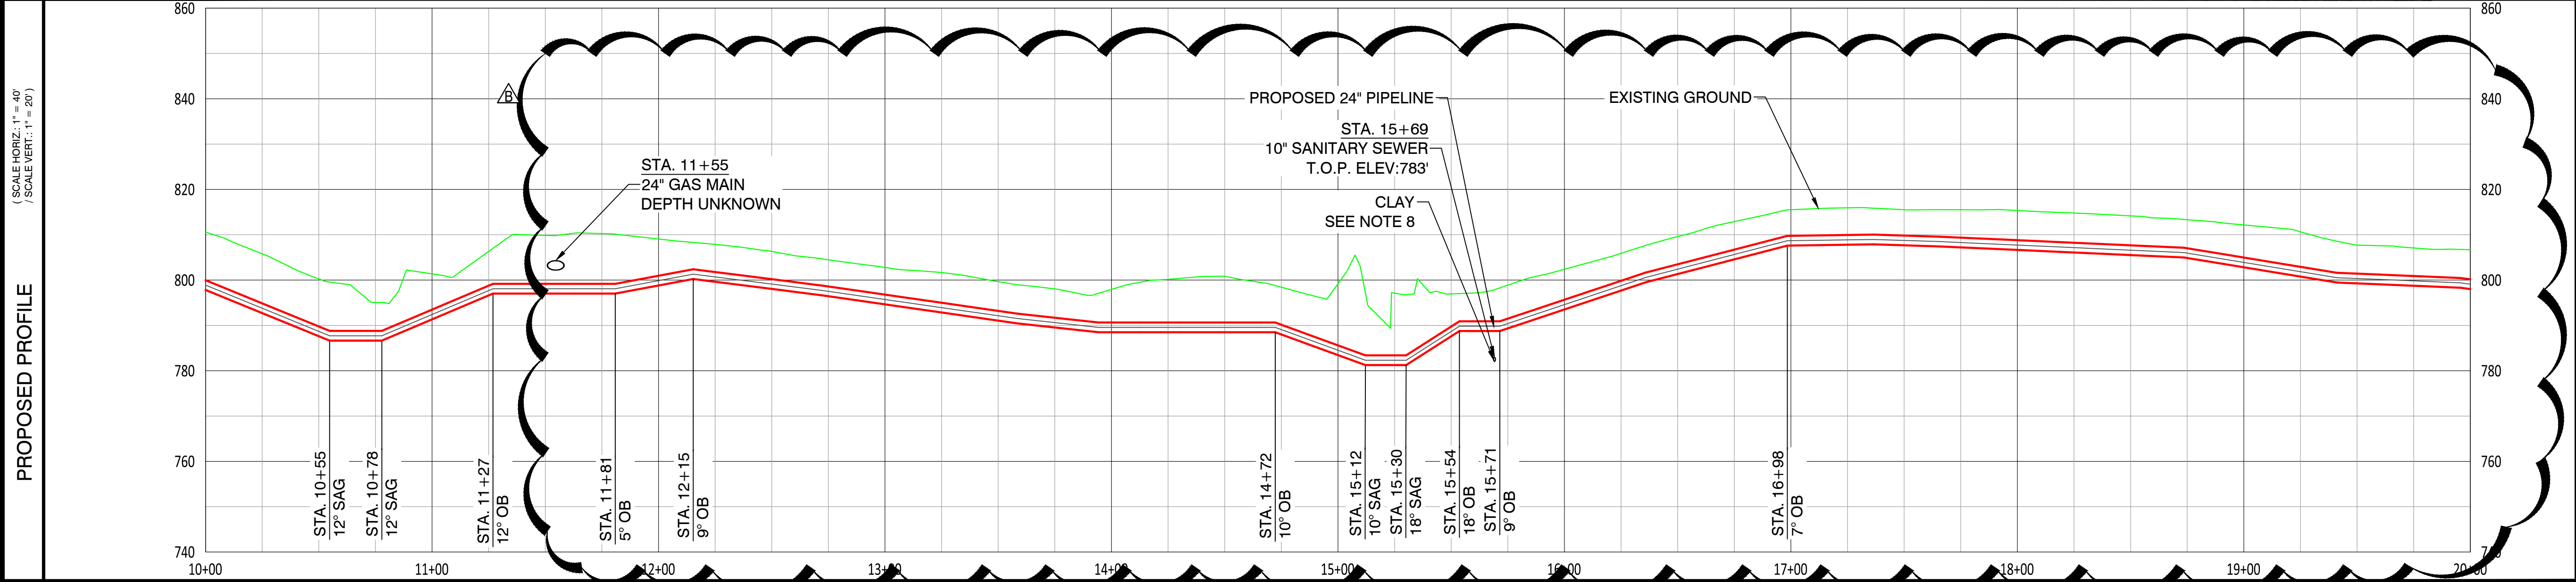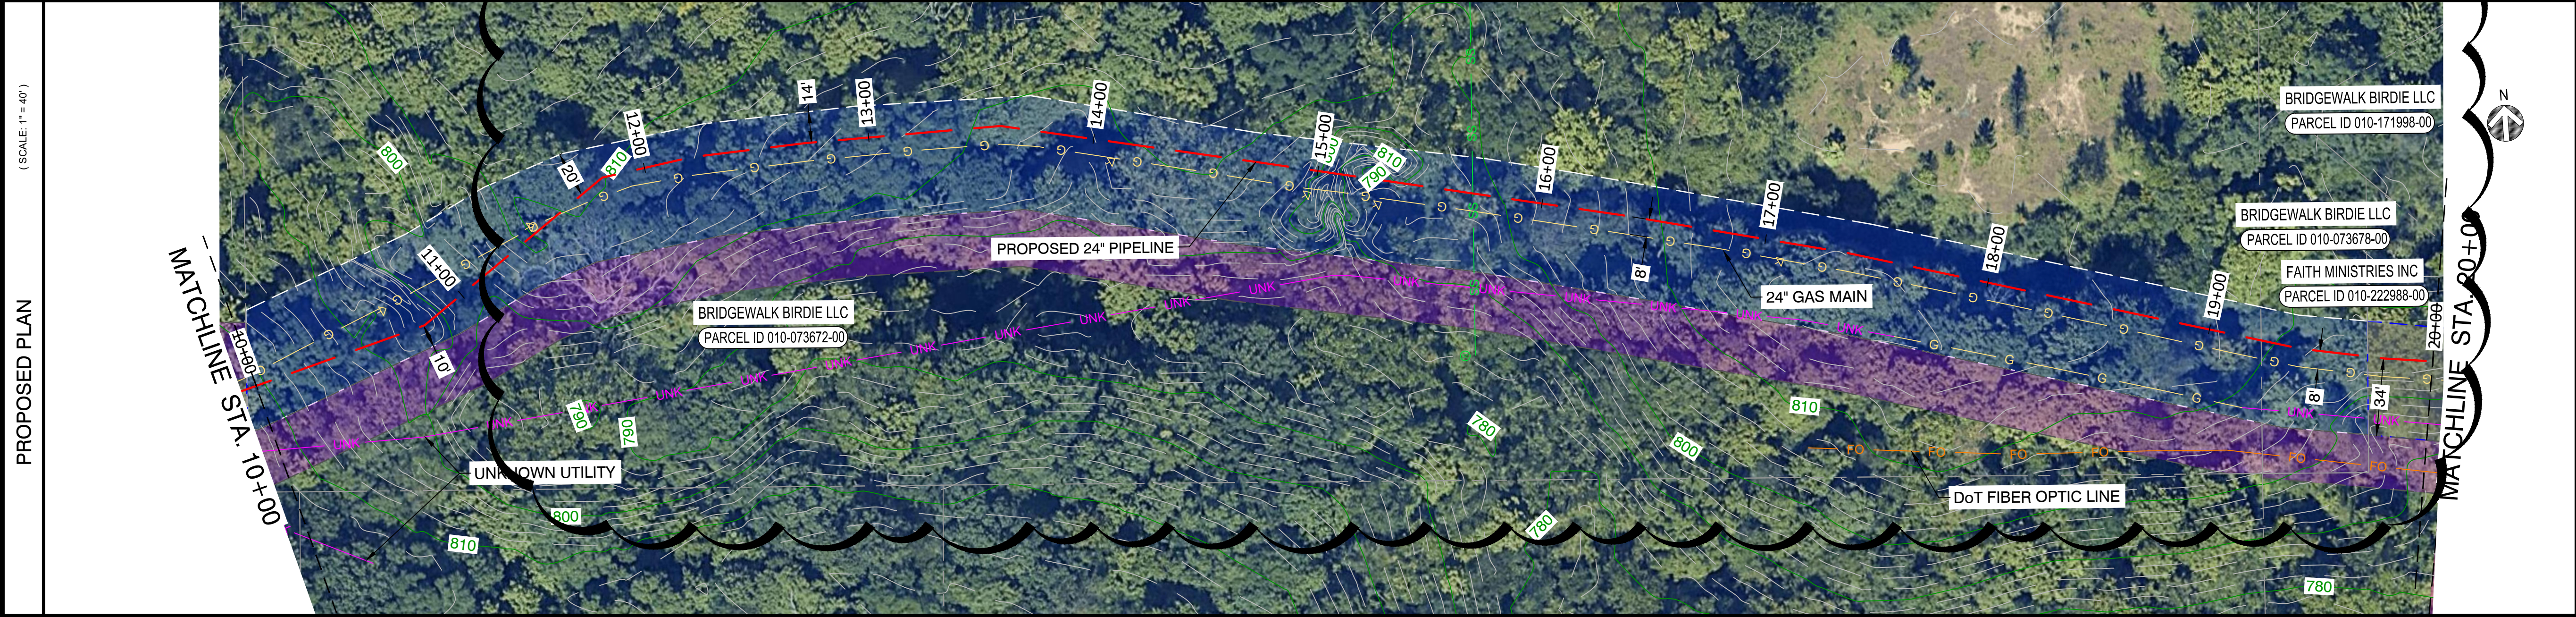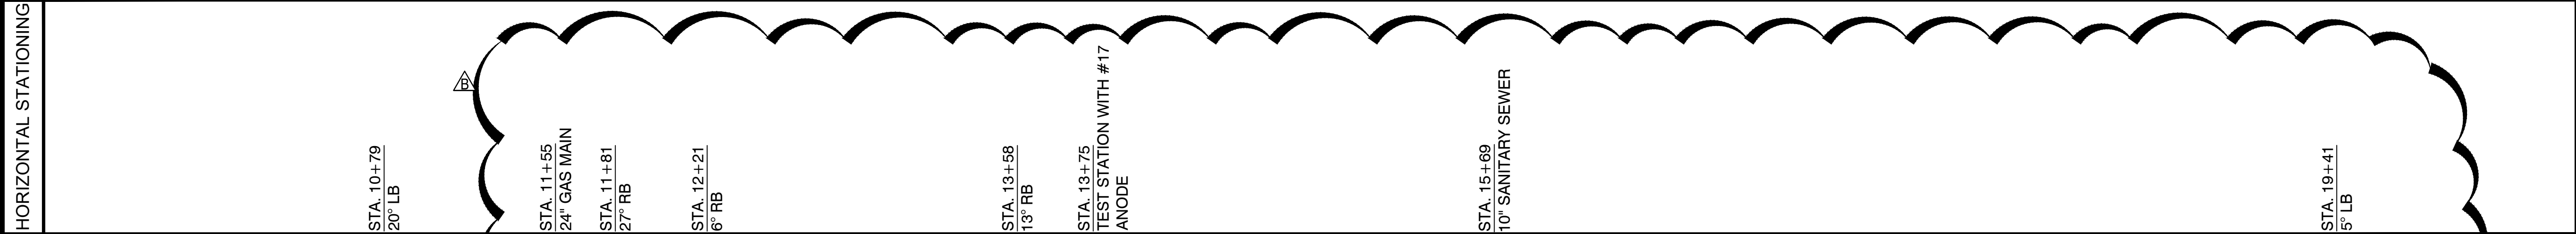

- NOTES:
- CONTRACTOR SHALL VERIFY ALL UTILITY CROSSINGS
 - SERVICE LINE CROSSINGS SHOWN IN SURVEY ARE NOT STATIONED OR SHOWN IN PROFILE FOR CLARITY
 - THE PIPELINE HAS GENERALLY BEEN DESIGNED WITH A COVER OF 6'-0" TO ACCOUNT FOR THE DEPTH OF UNKNOWN SERVICE LINES. MINIMUM ALLOWABLE DEPTH OF COVER IS 4'-0"
 - VERTICAL BENDS CALLED OUT IN PROFILE ARE FOR REFERENCE. CONTRACTOR TO MAKE USE OF ROPING AND FIELD BENDS WHERE POSSIBLE. REFER TO GS 3010.030 FOR FURTHER DETAILS
 - CORROSION PROTECTION IS DESIGNED BY NISOURCE AND IS NOT COVERED WITHIN THE ENGINEER'S STAMP
 - AERIAL IMAGERY IS FOR REFERENCE ONLY
 - FITTING EXTENTS SHOWN IN THE PROFILE ARE FOR REFERENCE ONLY. REFER TO STATIONING BAND FOR LOCATIONS OF ANTICIPATED FITTINGS. A 3X DIAMETER OF STRAIGHT PIPE IS REQUIRED BETWEEN ALL FITTINGS. REFER TO GS 2110.020 FOR FURTHER DETAILS
 - SANITARY SEWER MATERIAL IS CLAY. DO NOT EXPOSE SANITARY SEWER

NiSource

Ohio Utilities Protection Service
Call 811
before you dig

CAMPOS
EPC

401 N Front St, Suite 380, Columbus, OH 43215
(380) 799-8503

PROPOSED

REVISIONS			
B	07/03/25	REVISED FOR ALIGNMENT SHIFT	
A	12/23/24	ISSUED FOR PERMIT	
REV. #	DATE	DESCRIPTION	
INTERNAL ENG.	AD	12/23/24	614-981-0661
DESIGNED BY	JMJ	12/23/24	855-266-7671
CHECKED BY	RBW	12/23/24	855-266-7671
AS-BUILT BY	TBD	TBD	TBD
	NAME	DATE	PHONE #

SITE NAME:
INST# 23-0083895-00
ABAN# 23-0083897-00
PROJECT ID# 21-78793
AGLER ROAD NCHP PIPELINE PROJECT
COLUMBUS/GAHANNA, FRANKLIN COUNTY, OH


DRAWING TITLE:

STA. 10+00 TO STA. 20+00

DRAWING NO:

L-2003

ACCEPTED MANUSCRIPT

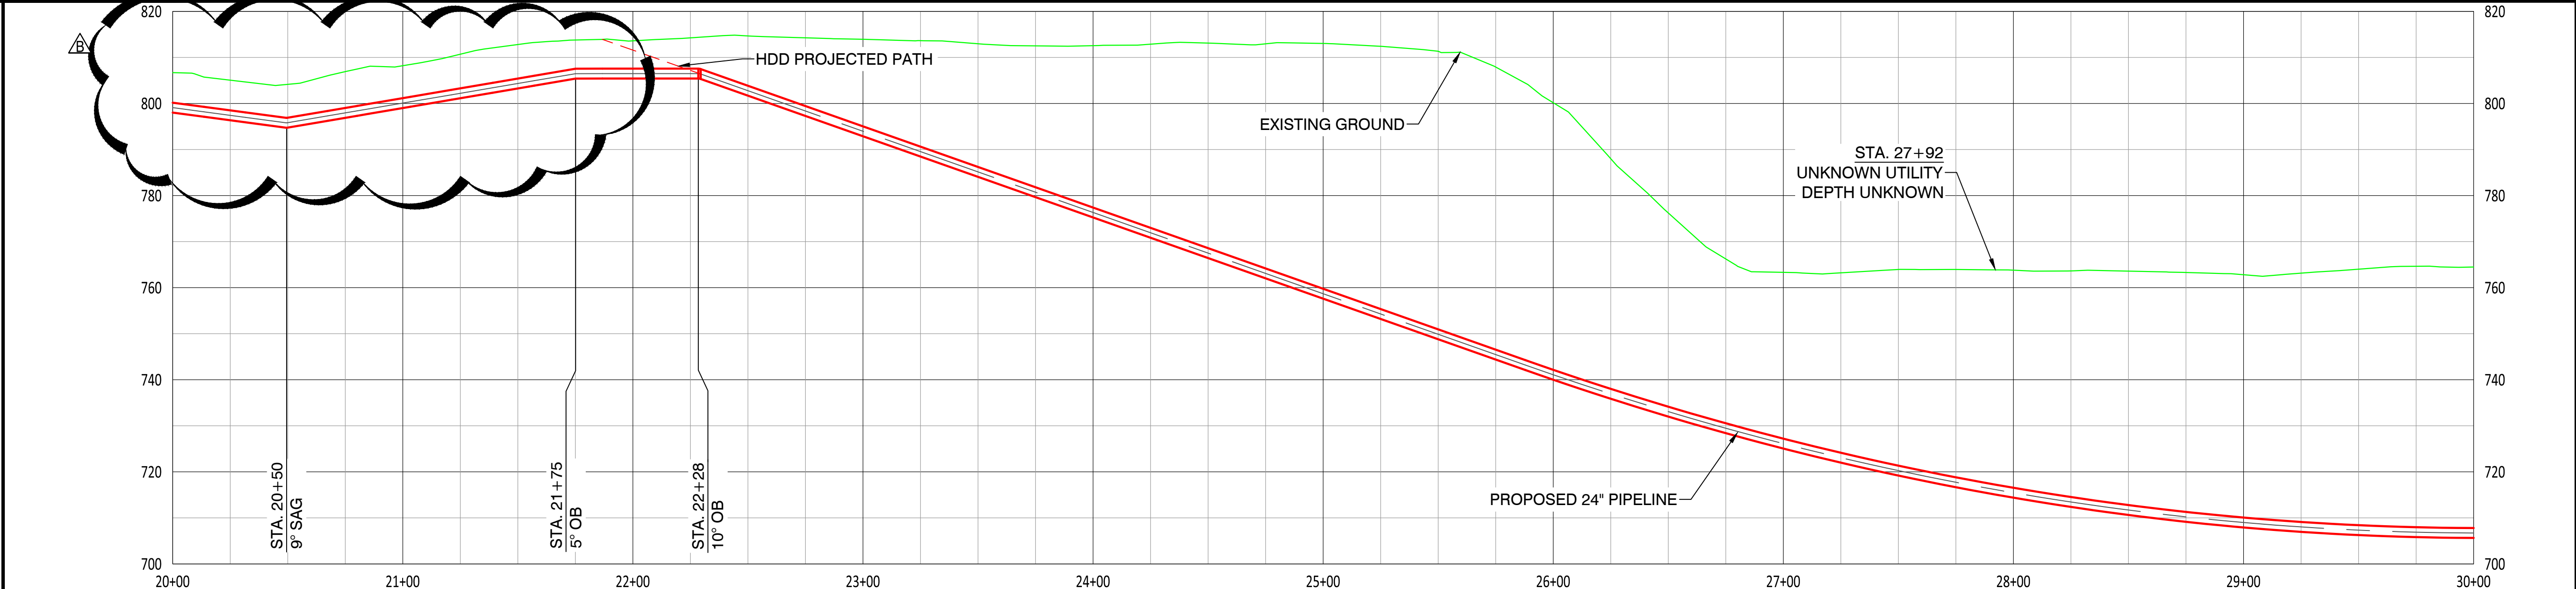

6. AERIAL IMAGERY IS FOR REFERENCE ONLY
7. FITTING EXTENTS SHOWN IN THE PROFILE ARE FOR REFERENCE ONLY. REFER TO STATIONING BAND FOR LOCATIONS OF ANTICIPATED FITTINGS. A 3X DIAMETER OF STRAIGHT PIPE IS REQUIRED BETWEEN ALL FITTINGS. REFER TO GS 2110.020 FOR FURTHER DETAILS

