



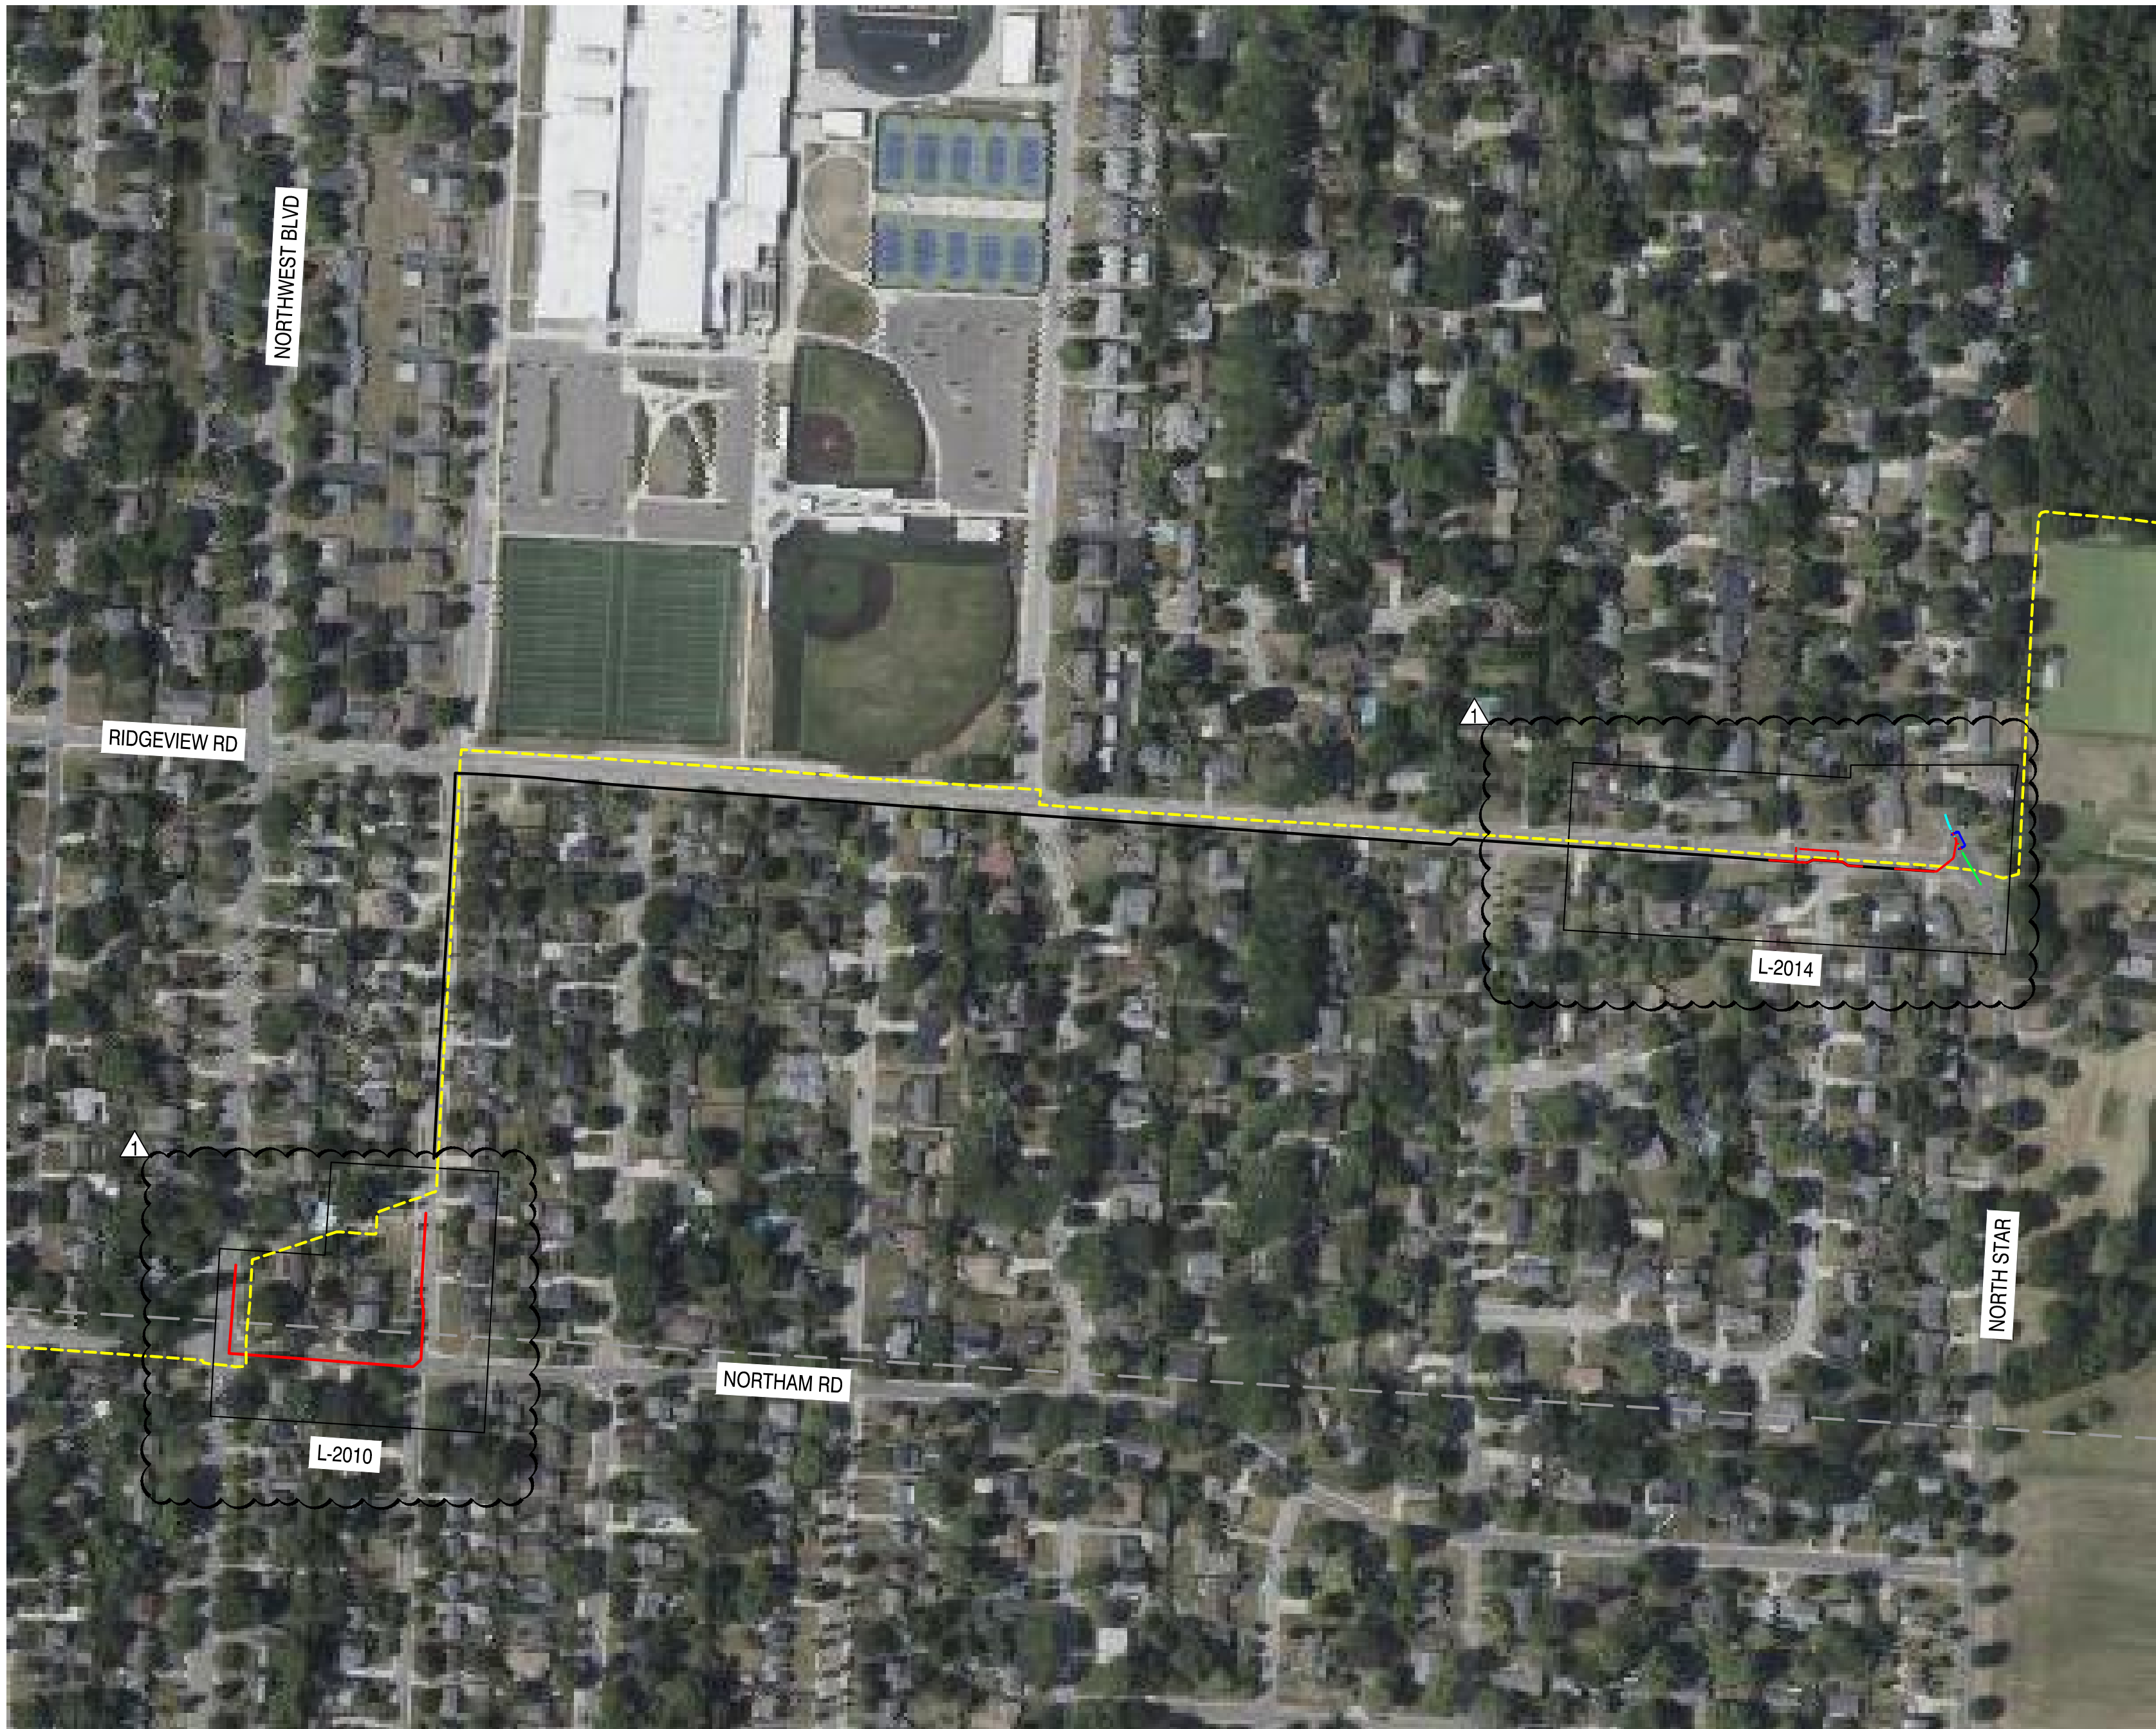

OVERVIEW SHEET INDEX
SCALE: 1"=200'

NOTE:
1. AERIAL IMAGERY IS FOR REFERENCE ONLY

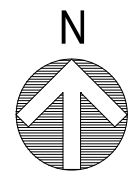

PROPOSED

REVISIONS		
1	08/01/25	ISSUED FOR TIE-IN SHIFT
0	10/21/24	ISSUED FOR PERMIT
REV. #	DATE	DESCRIPTION

INTERNAL ENG.	JW	05/31/23	855-226-7671
DESIGNED BY	JEM	05/31/23	855-266-7671
CHECKED BY	JMJ	05/31/23	855-226-7671
AS-BUILT BY	TBD	TBD	TBD
	NAME	DATE	PHONE #

SITE NAME:
INST# 23-0136341-00
ABAN# 23-0136342-00
INST# 24-0136890-00
ABAN# 24-0136891-00
PROJECT ID# 21-78791
NCHP PIPELINE REPLACEMENT, UNIVERSITY
UPPER ARLINGTON/ COLUMBUS/ FRANKLIN COUNTY, OH

DRAWING TITLE:



OVERVIEW SHEET

DRAWING NO:

O-2001

OWNERSHIP		CITY OF UPPER ARLINGTON	
JURISDICTION / PARCEL ID		CITY OF UPPER ARLINGTON / FRANKLIN COUNTY	
TEST PRESSURE / DESIGN INFO		1080 PSIG MIN / 1280 PSIG MAX / CLASS IV / 720 PSIG	
CONSTRUCTION METHOD		OPEN CUT	
PIPE (HORIZONTAL LENGTH)	STA. 48+00		STA. 55+00
FITTINGS (ACTUAL LENGTH)			

HORIZONTAL STATIONING

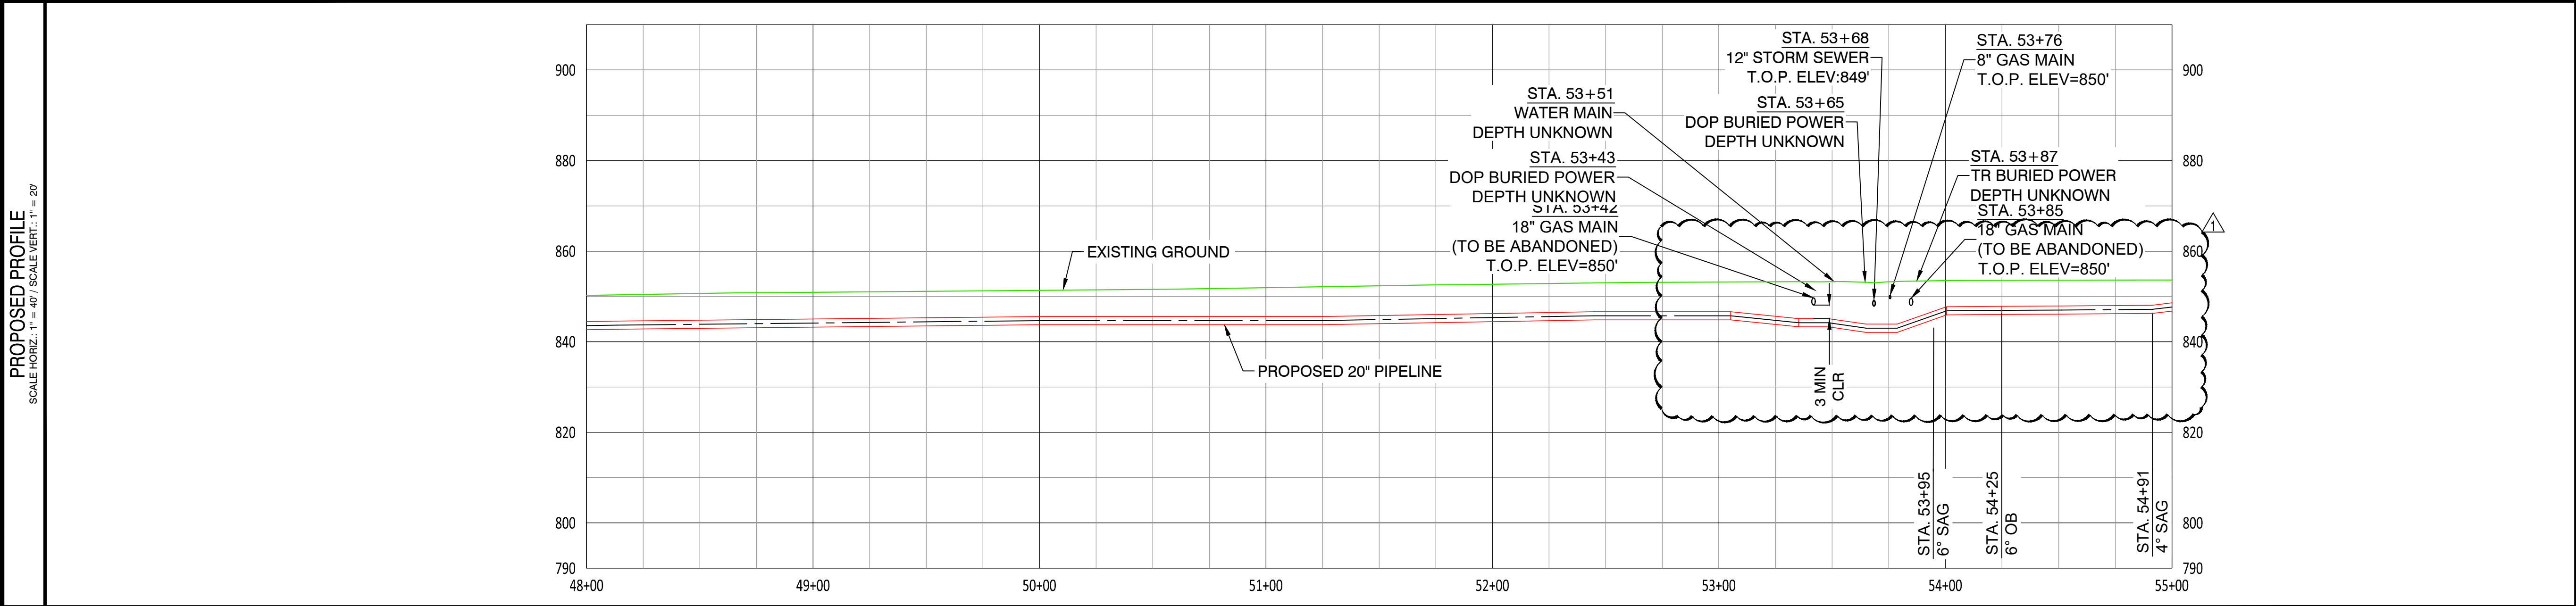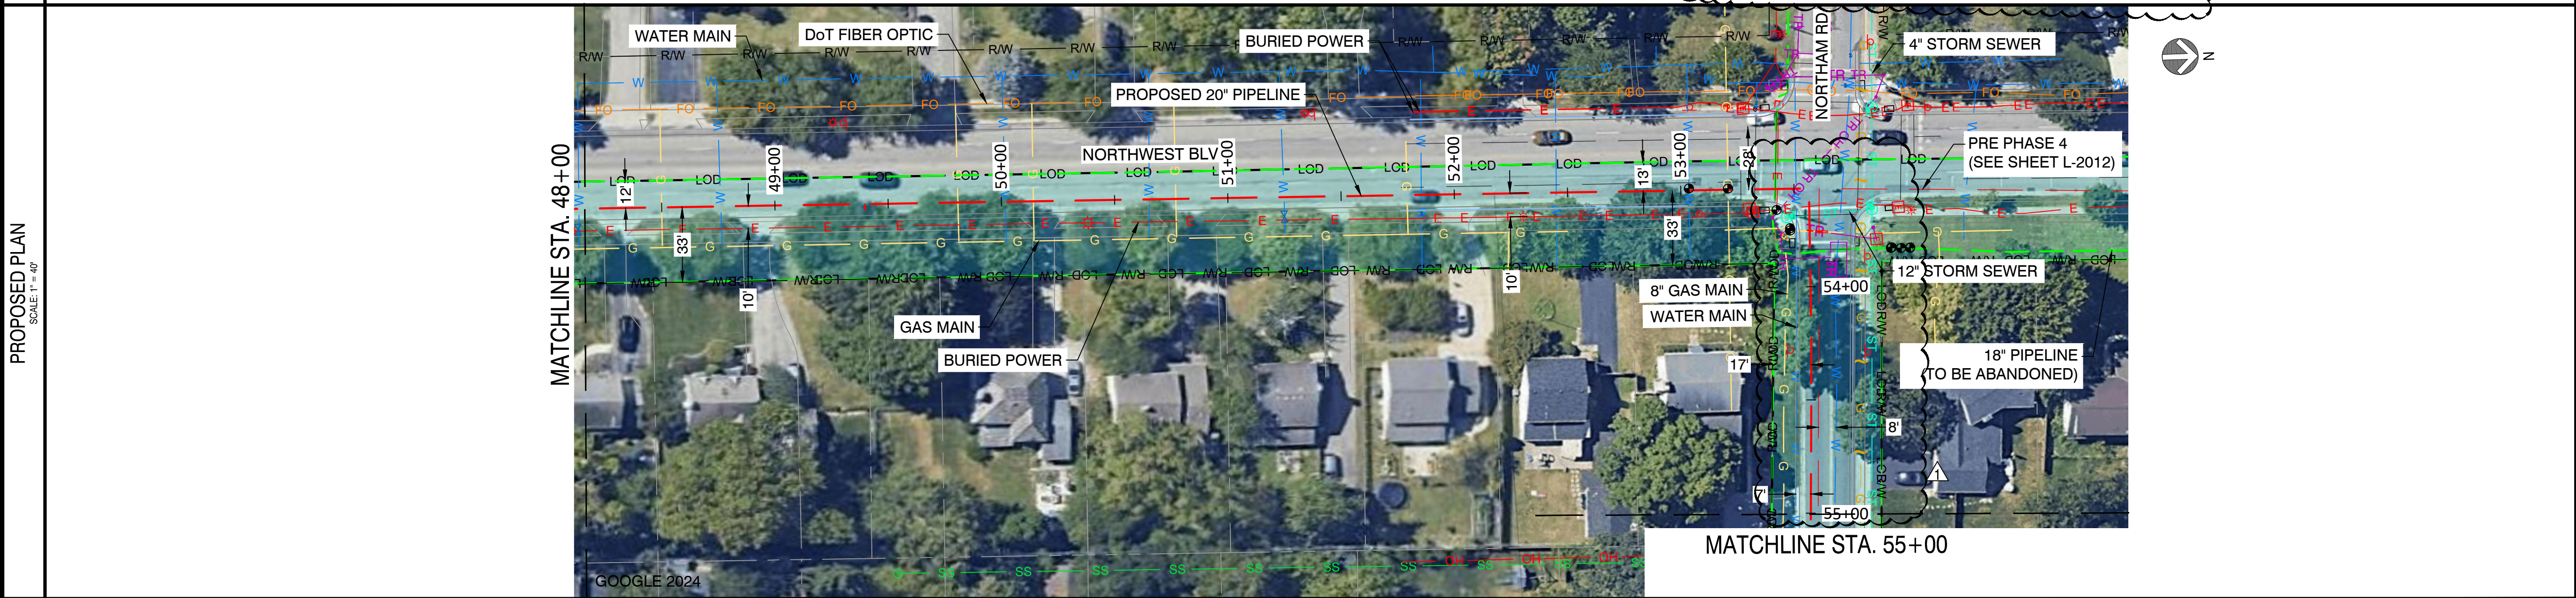

- NOTES:
- CONTRACTOR SHALL VERIFY ALL UTILITY CROSSINGS
 - SERVICE LINE CROSSINGS SHOWN IN SURVEY ARE NOT STATIONED OR SHOWN IN PROFILE FOR CLARITY
 - THE PIPELINE HAS GENERALLY BEEN DESIGNED WITH A COVER OF 6'-0" TO ACCOUNT FOR THE DEPTH OF UNKNOWN SERVICE LINES. MINIMUM ALLOWABLE DEPTH OF COVER IS 4'-0"
 - VERTICAL BENDS CALLED OUT IN PROFILE ARE FOR REFERENCE. CONTRACTOR TO MAKE USE OF ROPING AND FIELD BENDS WHERE POSSIBLE
 - CORROSION PROTECTION IS DESIGNED BY NISOURCE AND IS NOT COVERED WITHIN THE ENGINEER'S STAMP
 - AERIAL IMAGERY IS FOR REFERENCE ONLY



DRAFT

REVISIONS			
1	07/25/25	REVISED FOR CONSTRUCTION	
0	07/10/25	ISSUED FOR PERMIT	
REV. #	DATE	DESCRIPTION	
DESIGNED BY	EK	05/31/23	614-981-0661
DRAWN BY	JEM	05/31/23	855-266-7671
CHECKED BY	JMJ	05/31/23	855-226-7671
AS-BUILT BY	TBD	TBD	TBD
	NAME	DATE	PHONE #



SITE NAME:
INST# 24-0137354-00
ABAN# 24-0137355-00
INST# 24-0136890-00
ABAN# 24-0136891-00
PROJECT ID# 21-78791
NCHP PIPELINE REPLACEMENT, WEST CENTRAL
UPPER ARLINGTON, FRANKLIN COUNTY, OH

DRAWING TITLE:
20" TREMONT TO BRANDON ALIGNMENT
STA. 48+00 TO STA. 55+00

DRAWING NO:
L-2010

OWNERSHIP		CITY OF UPPER ARLINGTON	
JURISDICTION / PARCEL ID		CITY OF UPPER ARLINGTON / FRANKLIN COUNTY	
TEST PRESSURE / DESIGN INFO		1080 PSIG MIN / 1280 PSIG MAX / CLASS IV / 720 PSIG	
CONSTRUCTION METHOD		OPEN CUT	
PIPE (HORIZONTAL LENGTH)			
FITTINGS (ACTUAL LENGTH)			

HORIZONTAL STATIONING		STA. 55+21 8" SANITARY SEWER STA. 56+57 45" LB STA. 56+62 16" GAS MAIN STA. 56+72 8" WATER MAIN STA. 56+77 45" LB STA. 56+90 12" STORM SEWER STA. 57+57 11" LB STA. 57+82 11" RB STA. 58+62 18" GAS MAIN
-----------------------	--	---

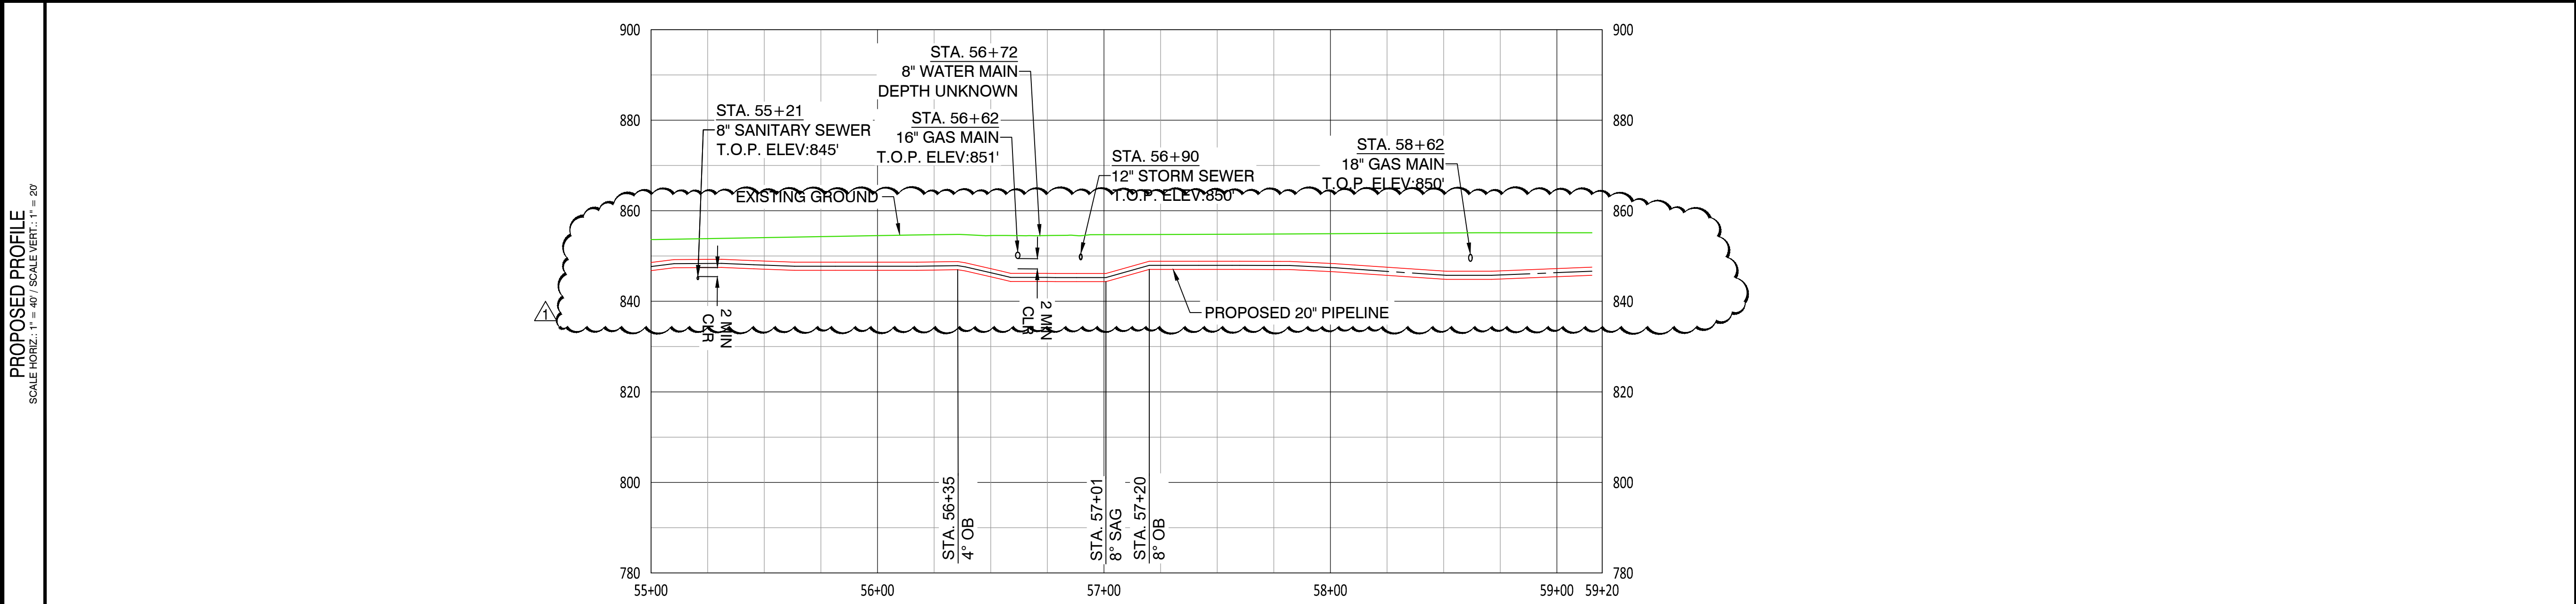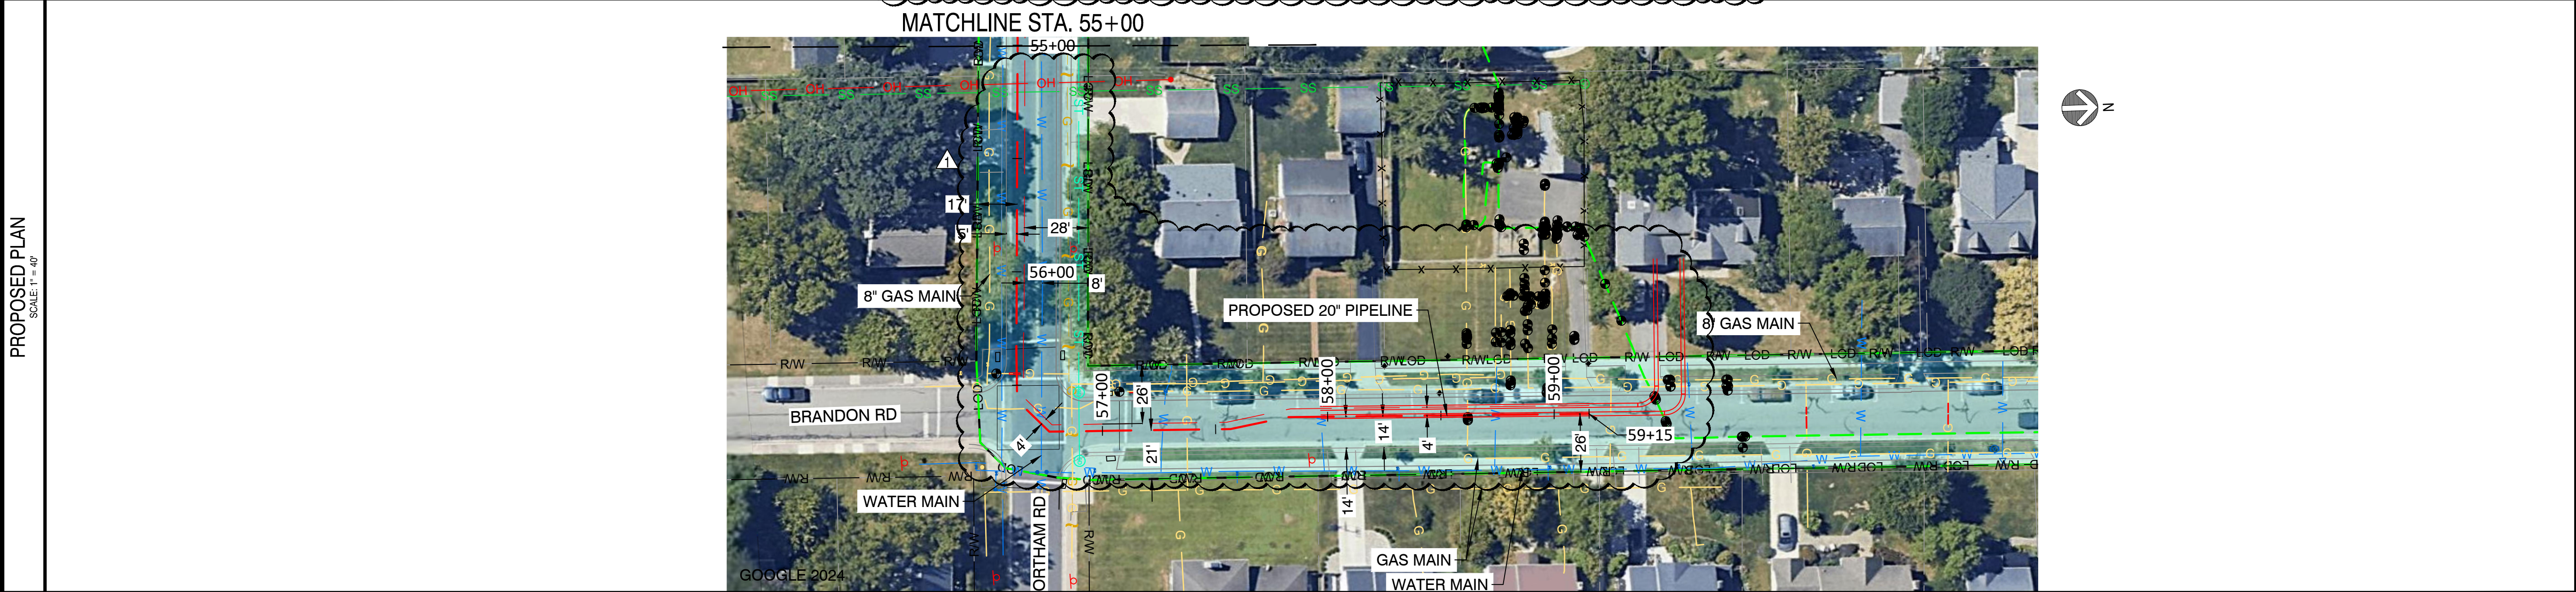

- NOTES:
- CONTRACTOR SHALL VERIFY ALL UTILITY CROSSINGS
 - SERVICE LINE CROSSINGS SHOWN IN SURVEY ARE NOT STATIONED OR SHOWN IN PROFILE FOR CLARITY
 - THE PIPELINE HAS GENERALLY BEEN DESIGNED WITH A COVER OF 6'-0" TO ACCOUNT FOR THE DEPTH OF UNKNOWN SERVICE LINES. MINIMUM ALLOWABLE DEPTH OF COVER IS 4'-0"
 - VERTICAL BENDS CALLED OUT IN PROFILE ARE FOR REFERENCE. CONTRACTOR TO MAKE USE OF ROPING AND FIELD BENDS WHERE POSSIBLE
 - CORROSION PROTECTION IS DESIGNED BY NISOURCE AND IS NOT COVERED WITHIN THE ENGINEER'S STAMP
 - AERIAL IMAGERY IS FOR REFERENCE ONLY

Ohio Utilities Protection Service

401 N Front St, Suite 380, Columbus, OH 43215
(303) 623-3345

DRAFT

REVISIONS			
REV. #	DATE	DESCRIPTION	
1	07/25/25	REVISED FOR CONSTRUCTION	
0	07/10/25	ISSUED FOR PERMIT	

SITE NAME:

INST# 24-0137354-00
ABAN# 24-0137355-00
INST# 24-0136890-00
ABAN# 24-0136891-00
PROJECT ID# 21-78791

NCHP PIPELINE REPLACEMENT, WEST CENTRAL
UPPER ARLINGTON, FRANKLIN COUNTY, OH

DRAWING TITLE:



**20" TREMONT TO BRANDON ALIGNMENT
STA. 55+00 TO STA. 59+01**

DRAWING NO:

L-2011

OWNERSHIP	CITY OF UPPER ARLINGTON
JURISDICTION / PARCEL ID	CITY OF UPPER ARLINGTON / FRANKLIN COUNTY
TEST PRESSURE / DESIGN INFO	1080 PSIG MIN / 1280 PSIG MAX / CLASS IV / 720 PSIG
CONSTRUCTION METHOD	OPEN CUT
PIPE	
FITTINGS	

HORIZONTAL STATIONING	STA. 28+04 20" X 16" REDUCING TEE STA. 28+22 30° LB COMBO 14° OB STA. 28+33 30° RB COMBO 14° SAG STA. 28+42 12" PROPOSED STORM SEWER STA. 28+64 20" BALL VALVE STA. 28+80 30° RB COMBO 5° OB STA. 28+91 30° LB COMBO 5° SAG STA. 28+93 DOP OVERHEAD POWER STA. 28+72 20" X 16" REDUCING TEE STA. 30+02 12" STORM SEWER STA. 30+09 DOP OVERHEAD POWER
-----------------------	--

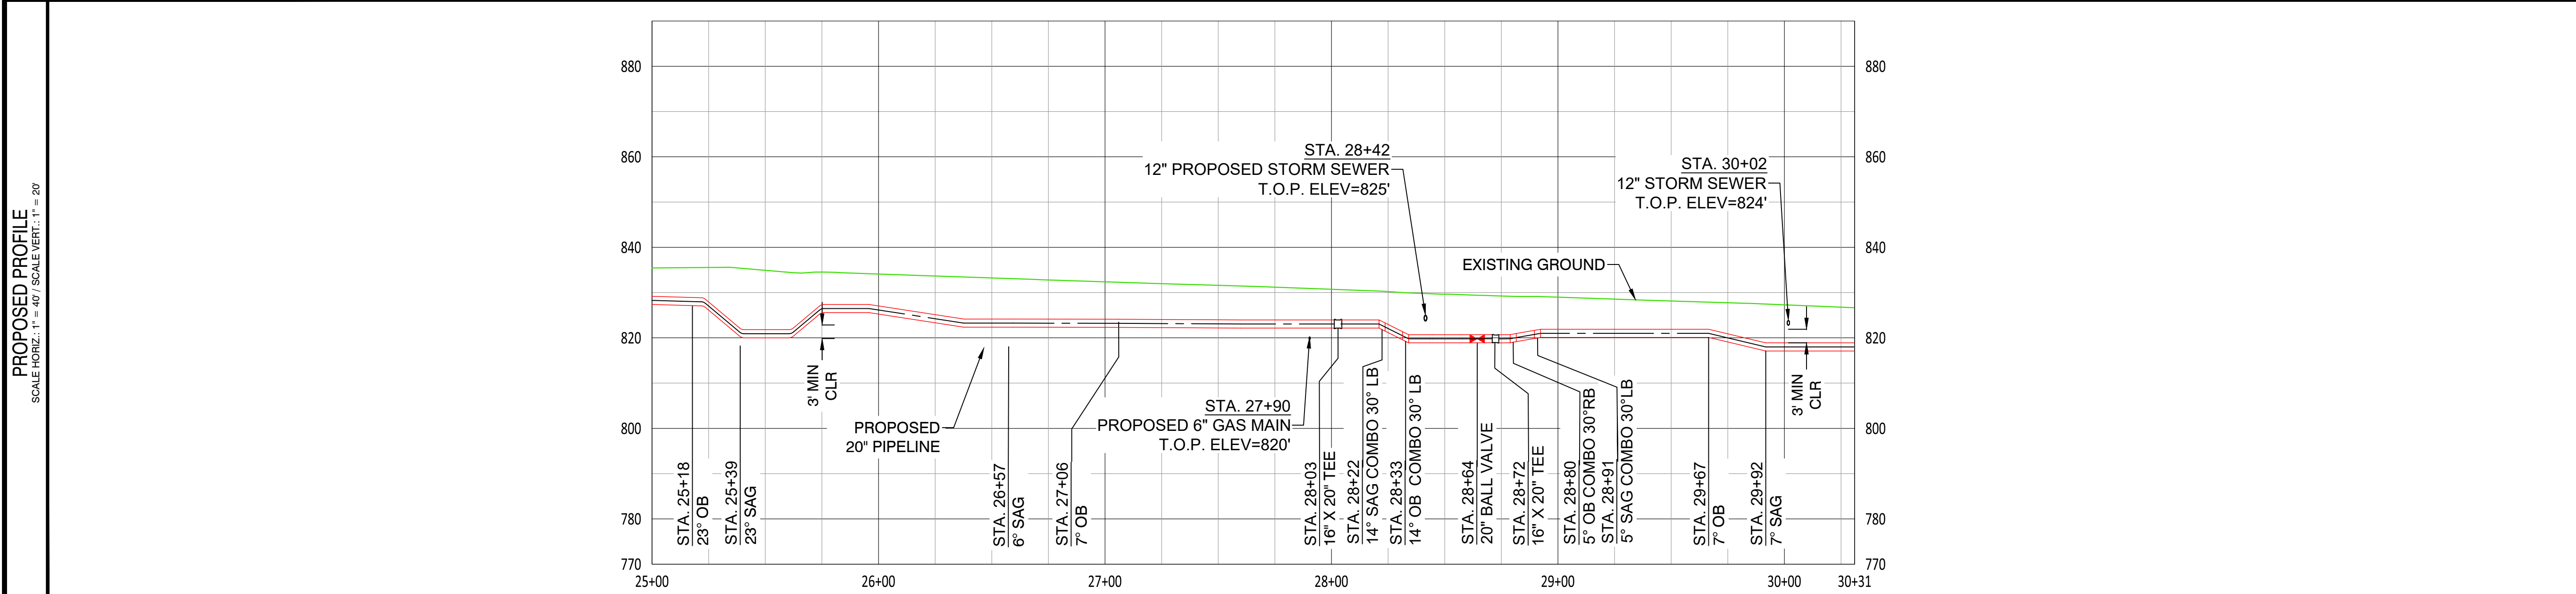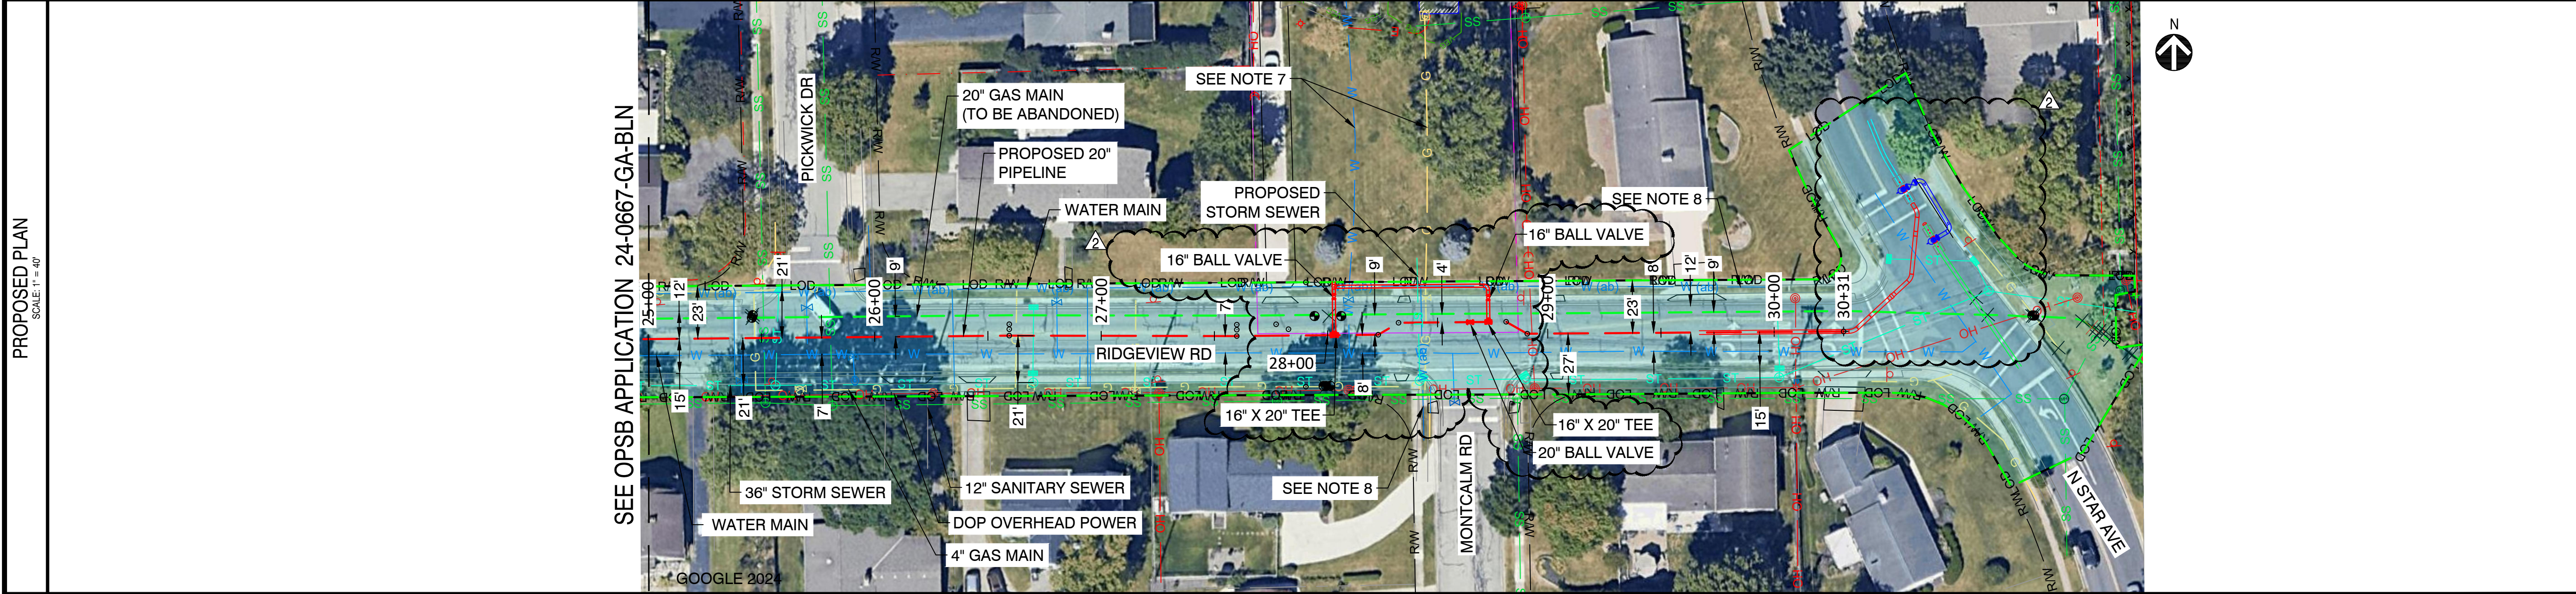

- NOTES:
1. CONTRACTOR SHALL VERIFY ALL UTILITY CROSSINGS

2. SERVICE LINE CROSSINGS SHOWN IN SURVEY ARE NOT STATIONED OR SHOWN IN PROFILE FOR CLARITY

3. THE PIPELINE HAS GENERALLY BEEN DESIGNED WITH A COVER OF 6'-0" TO ACCOUNT FOR THE DEPTH OF UNKNOWN SERVICE LINES. MINIMUM ALLOWABLE DEPTH OF COVER IS 4'-0"
4. VERTICAL BENDS CALLED OUT IN PROFILE ARE FOR REFERENCE. CONTRACTOR TO MAKE USE OF ROPING AND FIELD BENDS WHERE POSSIBLE. REFER TO GS 3010.030 FOR FURTHER DETAILS

5. CORROSION PROTECTION IS DESIGNED BY NISOURCE AND IS NOT COVERED WITHIN THE ENGINEER'S STAMP

6. AERIAL IMAGERY IS FOR REFERENCE ONLY
7. SERVICE LINES TO BE ABANDONED PRIOR TO CONSTRUCTION. REMOVE AS REQUIRED FOR CONSTRUCTION.

8. WATER MAINS ARE ABANDONED. REMOVE AS REQUIRED FOR CONSTRUCTION.

Ohio Utilities Protection Service

401 N Front St, Suite 380, Columbus, OH 43215
(303) 623-3345

DRAFT

REVISIONS			
REV. #	DATE	DESCRIPTION	
2	07/25/25	REVISED FOR TIE-IN SHIFT	
1	06/04/25	REVISED FOR FUTURE TIE-IN	
0	11/26/24	ISSUED FOR PERMIT	

DESIGNED BY		05/31/23	614-981-0661
DRAWN BY	JEM	05/31/23	855-266-7671
CHECKED BY	JMJ	05/31/23	855-226-7671
AS-BUILT BY	TBD	TBD	TBD
	NAME	DATE	PHONE #

SITE NAME:

INST# 24-0137354-00
ABAN# 24-0137355-00
INST# 24-0136890-00
ABAN# 24-0136891-00
PROJECT ID# 21-78791

NCHP PIPELINE REPLACEMENT, WEST CENTRAL
UPPER ARLINGTON, FRANKLIN COUNTY, OH

DRAWING TITLE:

**20" BRANDON TO RIDGEVIEW ALIGNMENT
BRIDLE / TIE-IN**

DRAWING NO:

L-2014