


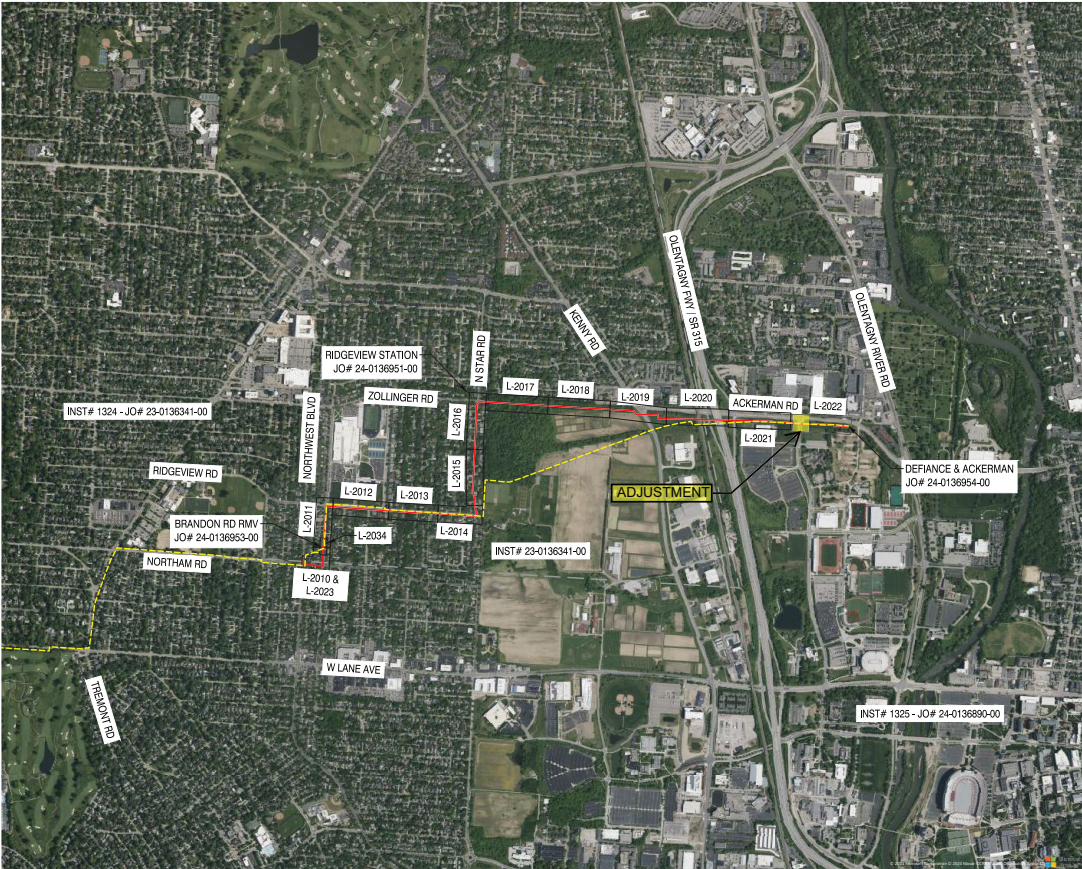

OVERVIEW SHEET INDEX
SCALE: 1"=1000'

NOTE:
1. AERIAL IMAGERY IS FOR REFERENCE ONLY



PROPOSED


REVISIONS		
REV. #	DATE	DESCRIPTION
0	10/21/24	ISSUED FOR PERMIT

INTERNAL ENG.	JW	05/31/23	855-226-7671
DESIGNED BY	JEM	05/31/23	855-226-7671
CHECKED BY	JMU	05/31/23	855-226-7671
AS-BUILT BY	TBD	TBD	TBD

SITE NAME:
INST# 23-0136341-00
ABAN# 23-0136342-00
INST# 24-0136890-00
ABAN# 24-0136891-00
PROJECT ID# 21-78791
NCHP PIPELINE REPLACEMENT, UNIVERSITY
UPPER ARLINGTON/ COLUMBUS/ FRANKLIN COUNTY, OH

DRAWING TITLE:
OVERVIEW SHEET

DRAWING NO:
O-2001

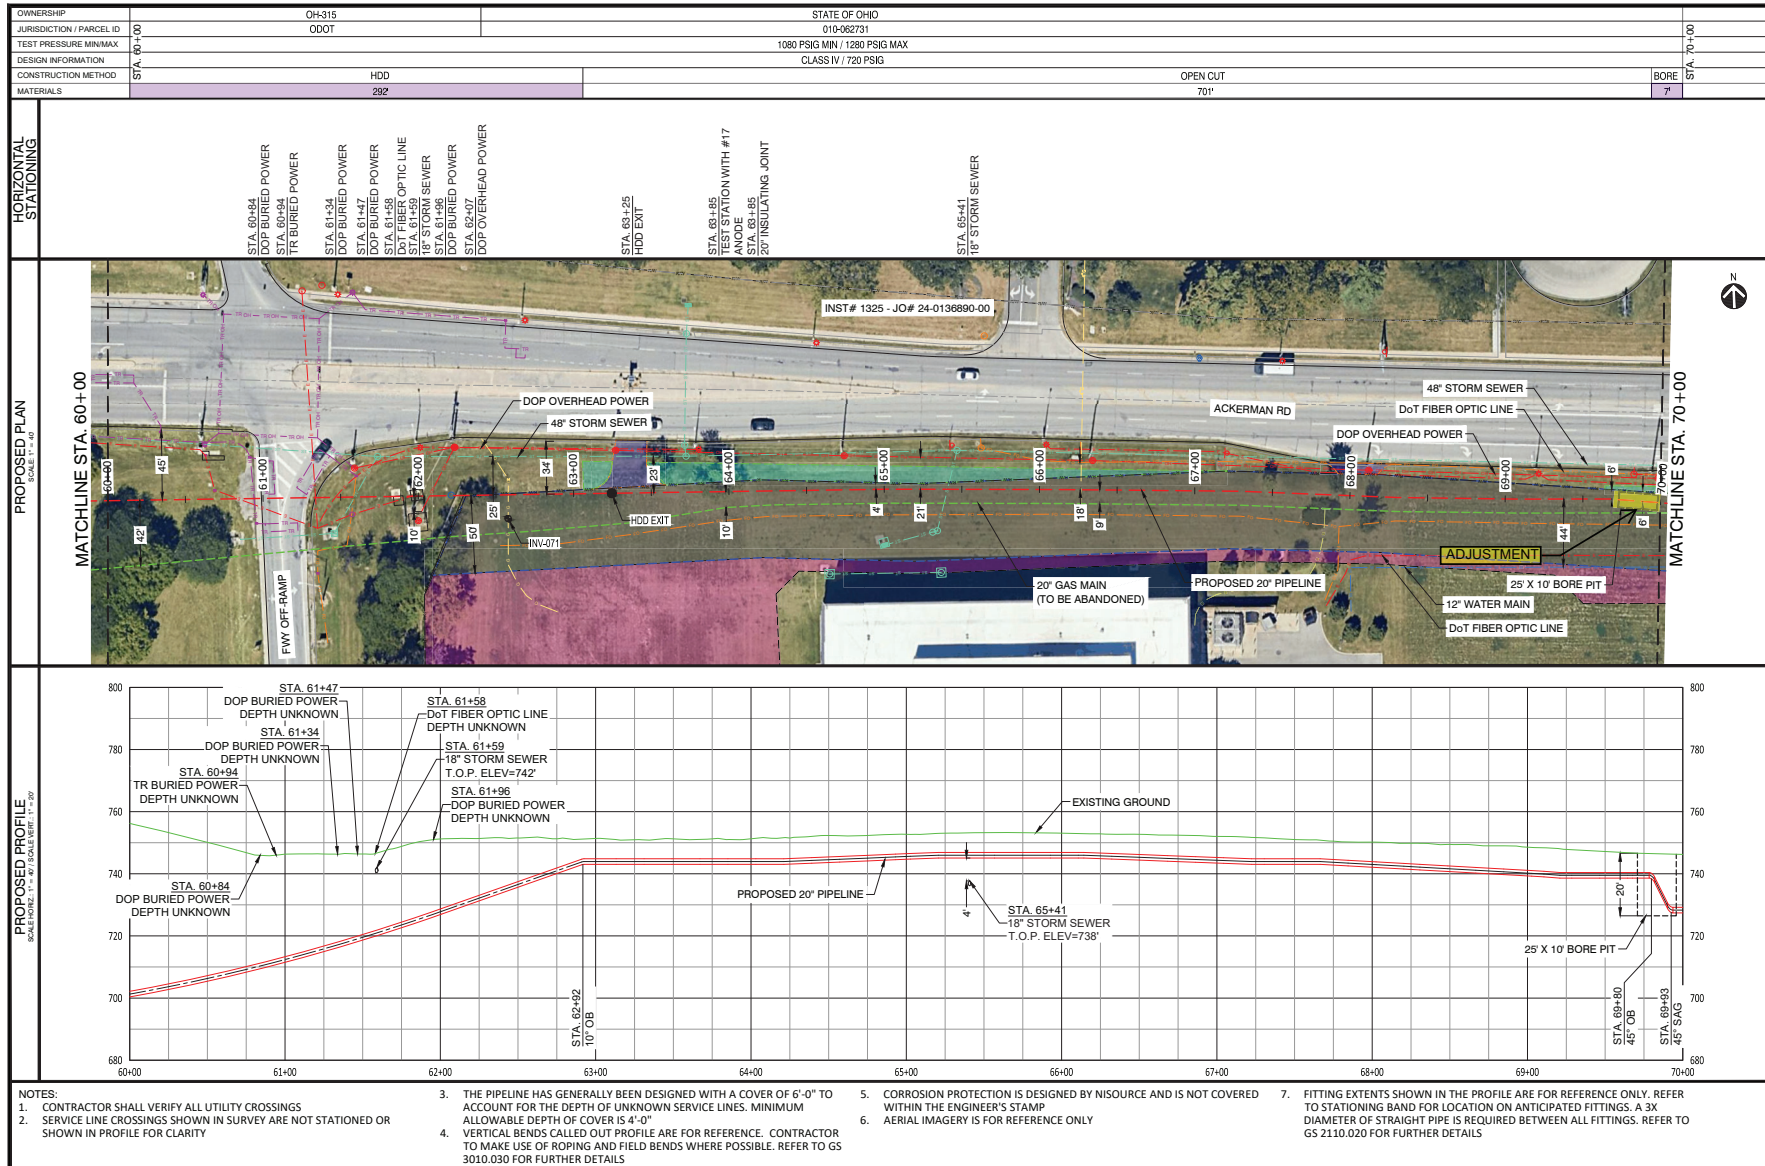

NISource

Ohio Trench Protection Service
Call 811
before you dig

CAMPOS
EPC
401 N Front St, Suite 380, Columbus, OH 43215
(380) 799-8503

PROPOSED

REVISIONS

REV. #	DATE	DESCRIPTION
0	11/26/24	ISSUED FOR PERMIT
1		
2		
3		
4		
5		
6		
7		
8		
9		
10		

SITE NAME:
INST# 23-0136341-00
ABAN# 23-0136342-00
INST# 24-0136890-00
ABAN# 24-0136891-00
PROJECT ID# 21-78791
 NCHP PIPELINE REPLACEMENT, WEST CENTRAL
 UPPER ARLINGTON/ COLUMBUS / FRANKLIN COUNTY, OH

DRAWING TITLE:
20" PIPELINE ALIGNMENT
STA. 60+00 TO STA. 70+00

DRAWING NO:
L-2021

REVISIONS

0	11/26/24	ISSUED FOR PERMIT
REV. #	DATE	DESCRIPTION



INTERNAL ENG.	EK	05/31/23	614-981-0661
DESIGNED BY	JEM	05/31/23	855-266-7671
CHECKED BY	JMJ	05/31/23	855-226-7671
AS-BUILT BY	TBD	TBD	TBD
	NAME	DATE	PHONE #

SITE NAME:
INST# 23-0136341-00
ABAN# 23-0136342-00
INST# 24-0136890-00
ABAN# 24-0136891-00
PROJECT ID# 21-78791
 NCHP PIPELINE REPLACEMENT, WEST CENTRAL
 UPPER ARLINGTON/ COLUMBUS / FRANKLIN COUNTY, OH

DRAWING TITLE:
20" PIPELINE ALIGNMENT
STA. 70+00 TO STA. 79+41

DRAWING NO:
L-2022

PROPOSED PLAN
SCALE: 1" = 40'

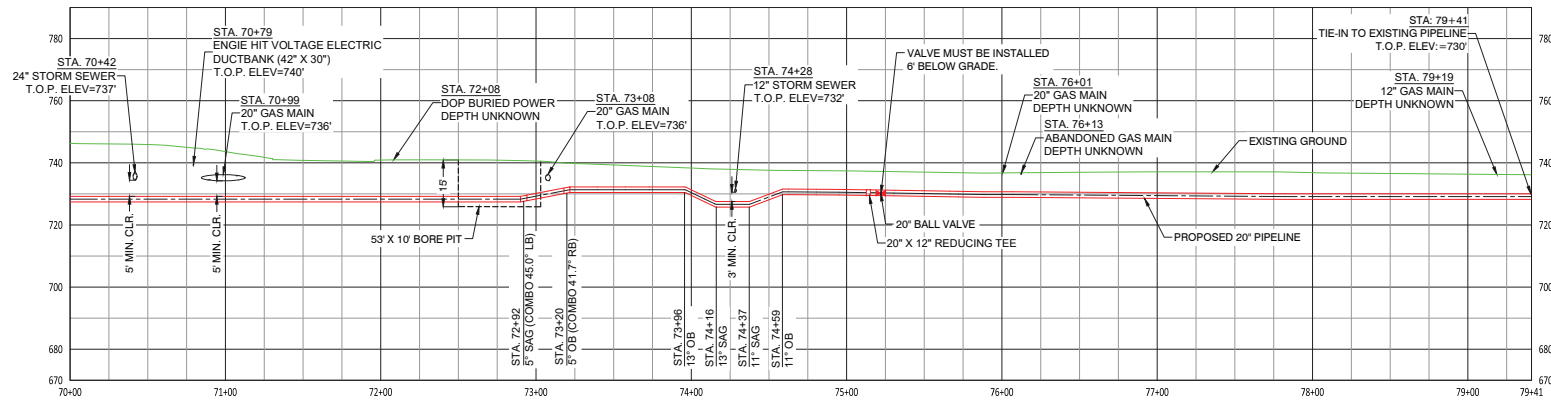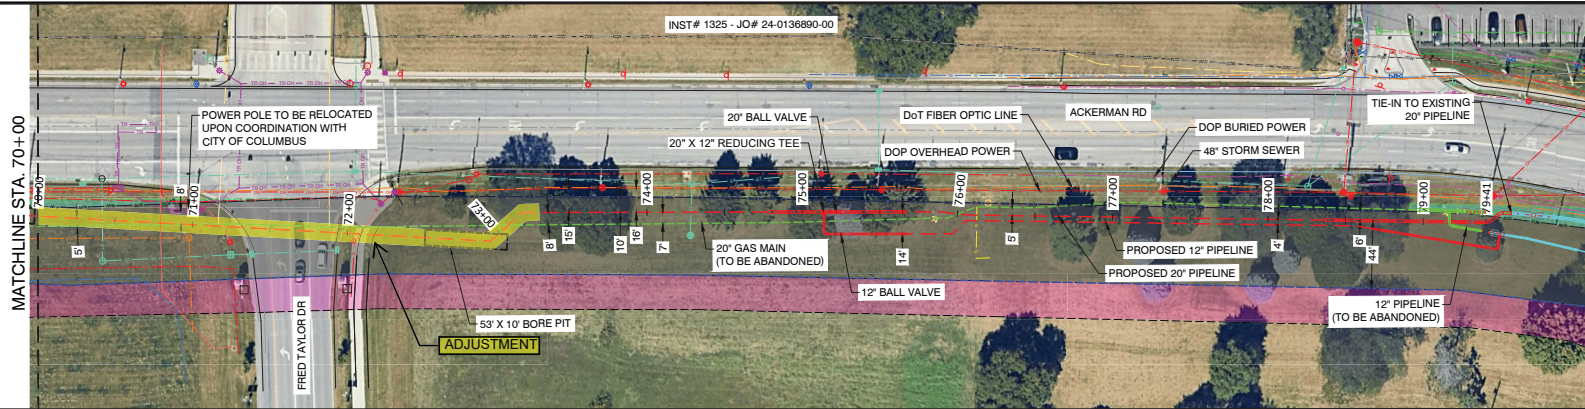

- | | | | |
|---|---|---|--|
| <p>NOTES:</p> <ol style="list-style-type: none"> 1. CONTRACTOR SHALL VERIFY ALL UTILITY CROSSINGS 2. SERVICE LINE CROSSINGS SHOWN IN SURVEY ARE NOT STATIONED OR SHOWN IN PROFILE FOR CLARITY | <ol style="list-style-type: none"> 3. THE PIPELINE HAS GENERALLY BEEN DESIGNED WITH A COVER OF 6'-0" TO ACCOUNT FOR THE DEPTH OF UNKNOWN SERVICE LINES. MINIMUM ALLOWABLE DEPTH OF COVER IS 4'-0" 4. VERTICAL BENDS CALLED OUT PROFILE ARE FOR REFERENCE. CONTRACTOR TO MAKE USE OF ROPING AND FIELD BENDS WHERE POSSIBLE. REFER TO GS 3010.030 FOR FURTHER DETAILS | <ol style="list-style-type: none"> 5. CORROSION PROTECTION IS DESIGNED BY NISOURCE AND IS NOT COVERED WITHIN THE ENGINEER'S STAMP 6. AERIAL IMAGERY IS FOR REFERENCE ONLY | <ol style="list-style-type: none"> 7. FITTING EXTENTS SHOWN IN THE PROFILE ARE FOR REFERENCE ONLY. REFER TO STATIONING BAND FOR LOCATION ON ANTICIPATED FITTINGS. A 3X DIAMETER OF STRAIGHT PIPE IS REQUIRED BETWEEN ALL FITTINGS. REFER TO GS 2110.020 FOR FURTHER DETAILS |
|---|---|---|--|