



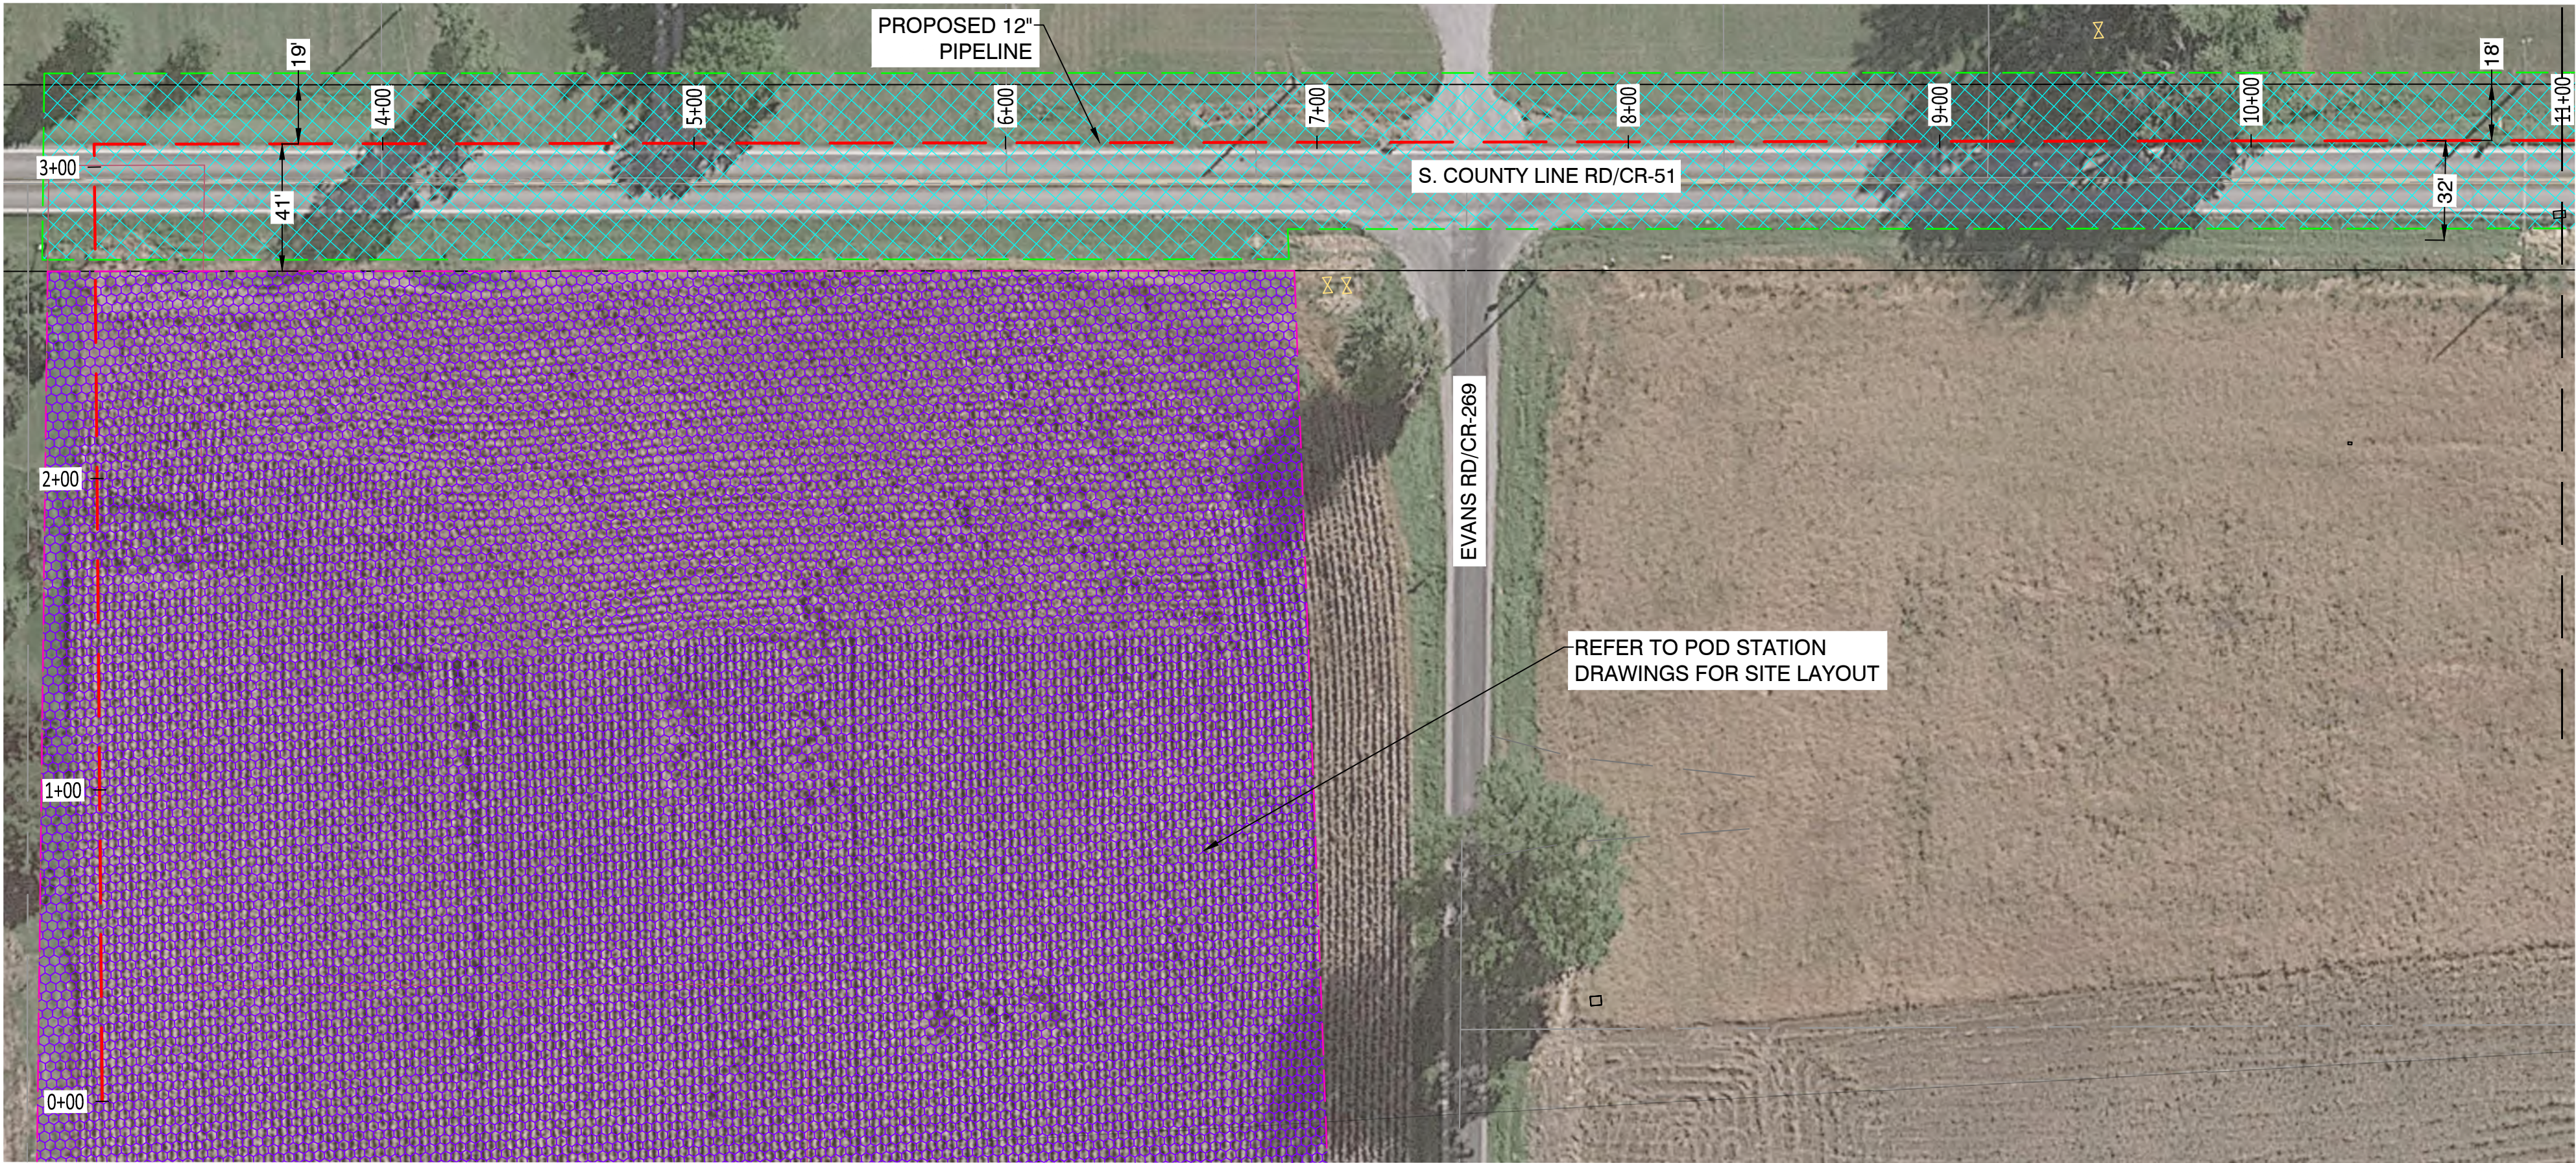


PROPOSED PLAN - 0+00 TO 11+00
(SCALE: 1" = 40')

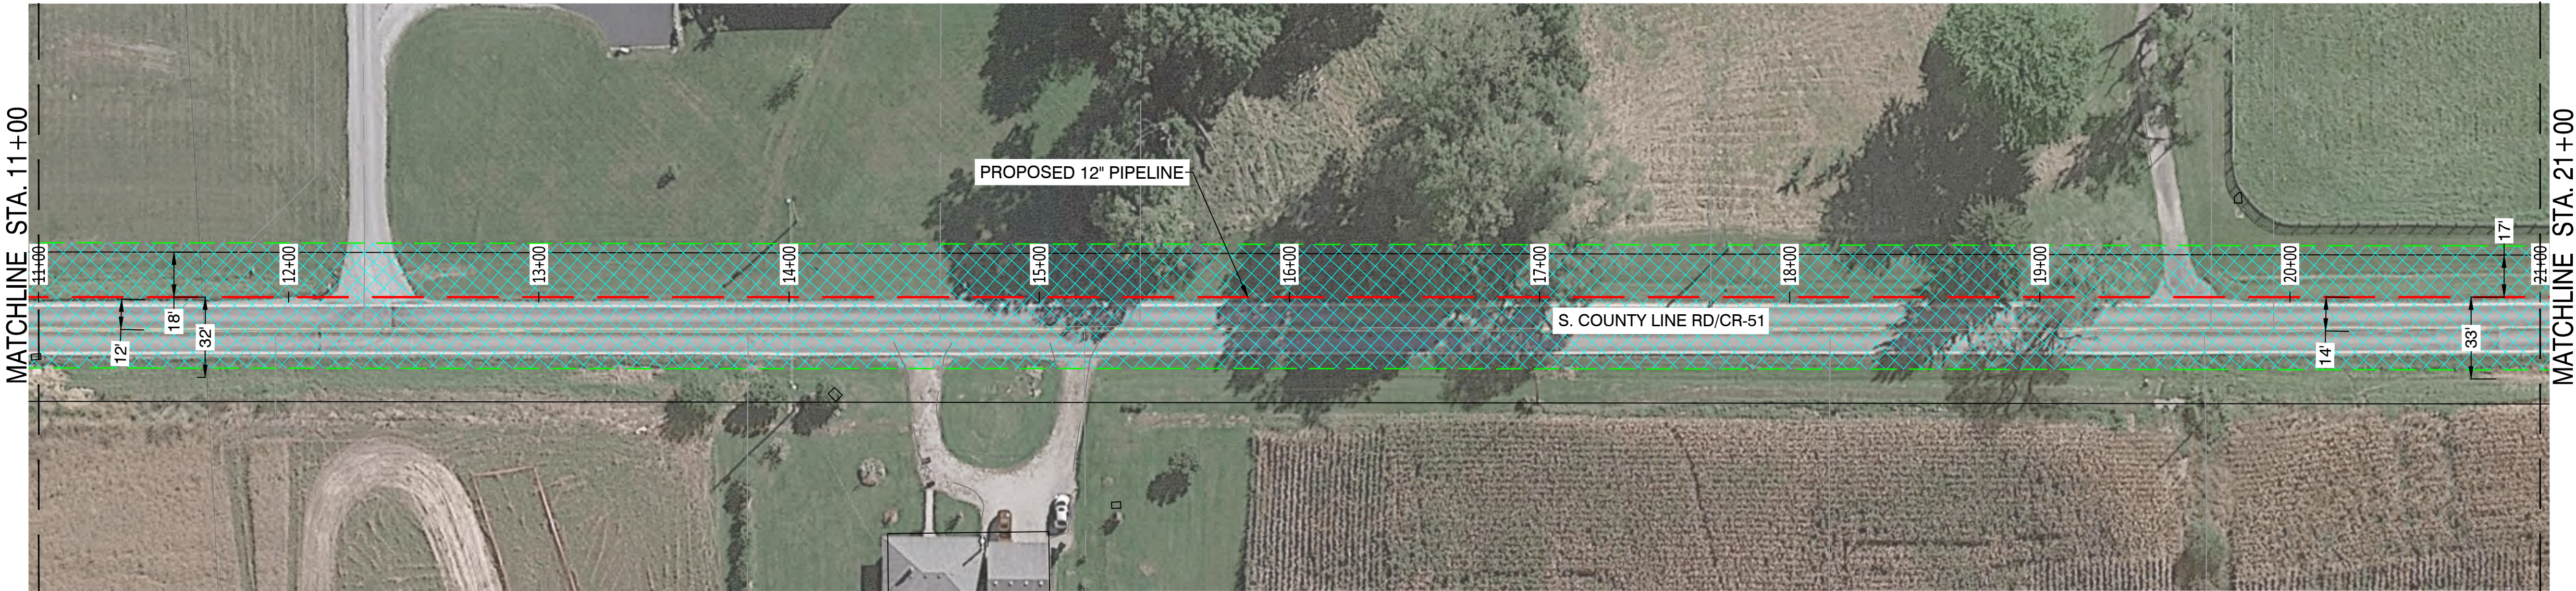

PROPOSED PLAN - 11+00 TO 21+00
(SCALE: 1" = 40')

NOTE:
1. AERIAL IMAGERY IS FOR REFERENCE ONLY

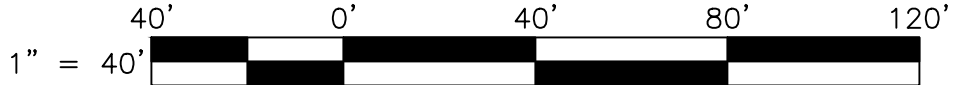

NiSource

Ohio Utilities Protection Service
Call 811
before you dig



6/9/2023

CAMPOS
EPC

200 W Adams, Suite 400, Chicago, IL 60606
(708) 505-5313

PROPOSED

REVISIONS			
2	06/09/23	REVISED FOR DOT COMMENT	
1	05/05/23	UPDATED INST#	
0	03/17/23	ISSUED FOR CONSTRUCTION	
REV. #	DATE	DESCRIPTION	
DESIGNED BY	J. JORDAN	03/17/23	708-505-5313
DRAWN BY	A. McMICHAEL	03/17/23	708-505-5313
CHECKED BY	S. WACH	03/17/23	708-505-5313
AS-BUILT BY			
	NAME	DATE	PHONE #


SITE NAME:
INST# 23-0083545-00 & 23-0083546-00
PROJECT ID# 21-85257
INTEL PROJECT SLICE
NEW ALBANY, LICKING COUNTY, OH

DRAWING TITLE:
EASEMENT & WORKSPACE
STA 0+00 TO STA 21+00

DRAWING NO:
L-100




PROPOSED PLAN - 21+00 TO 31+00
(SCALE: 1" = 40')

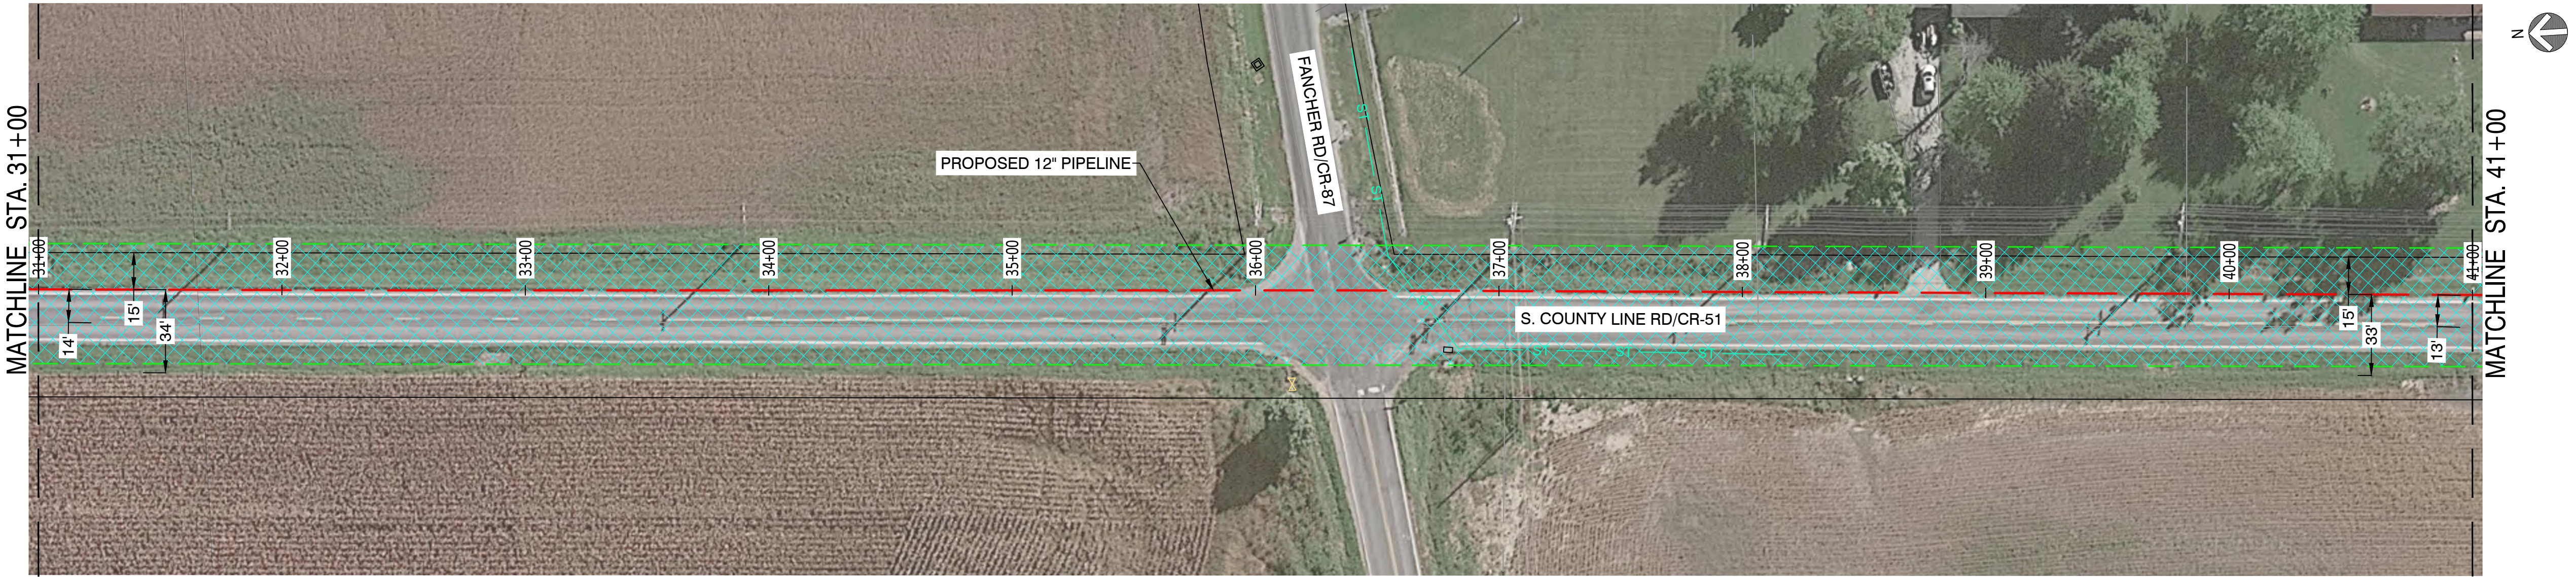

PROPOSED PLAN - 31+00 TO 41+00
(SCALE: 1" = 40')

NOTE:
1. AERIAL IMAGERY IS FOR REFERENCE ONLY

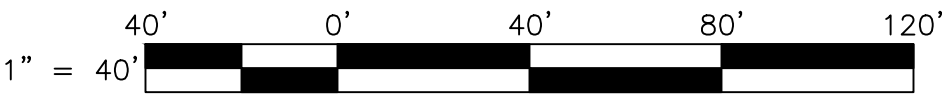

NiSource

Ohio Utilities Protection Service
Call 811
before you dig



6/9/2023

CAMPOS
EPC
200 W Adams, Suite 400, Chicago, IL 60606
(708) 505-5313

PROPOSED


REVISIONS			
REV. #	DATE	DESCRIPTION	
2	06/09/23	REVISED FOR DOT COMMENT	
1	05/05/23	UPDATED INST#	
0	03/17/23	ISSUED FOR CONSTRUCTION	

DESIGNED BY	J. JORDAN	03/17/23	708-505-5313
DRAWN BY	A. McMICHAEL	03/17/23	708-505-5313
CHECKED BY	S. WACH	03/17/23	708-505-5313
AS-BUILT BY			
NAME		DATE	PHONE #

SITE NAME:
INST# 23-0083545-00 & 23-0083546-00
PROJECT ID# 21-85257
INTEL PROJECT SLICE
NEW ALBANY, LICKING COUNTY, OH

DRAWING TITLE:
EASEMENT & WORKSPACE
STA 21+00 TO STA 41+00

DRAWING NO:
L-101

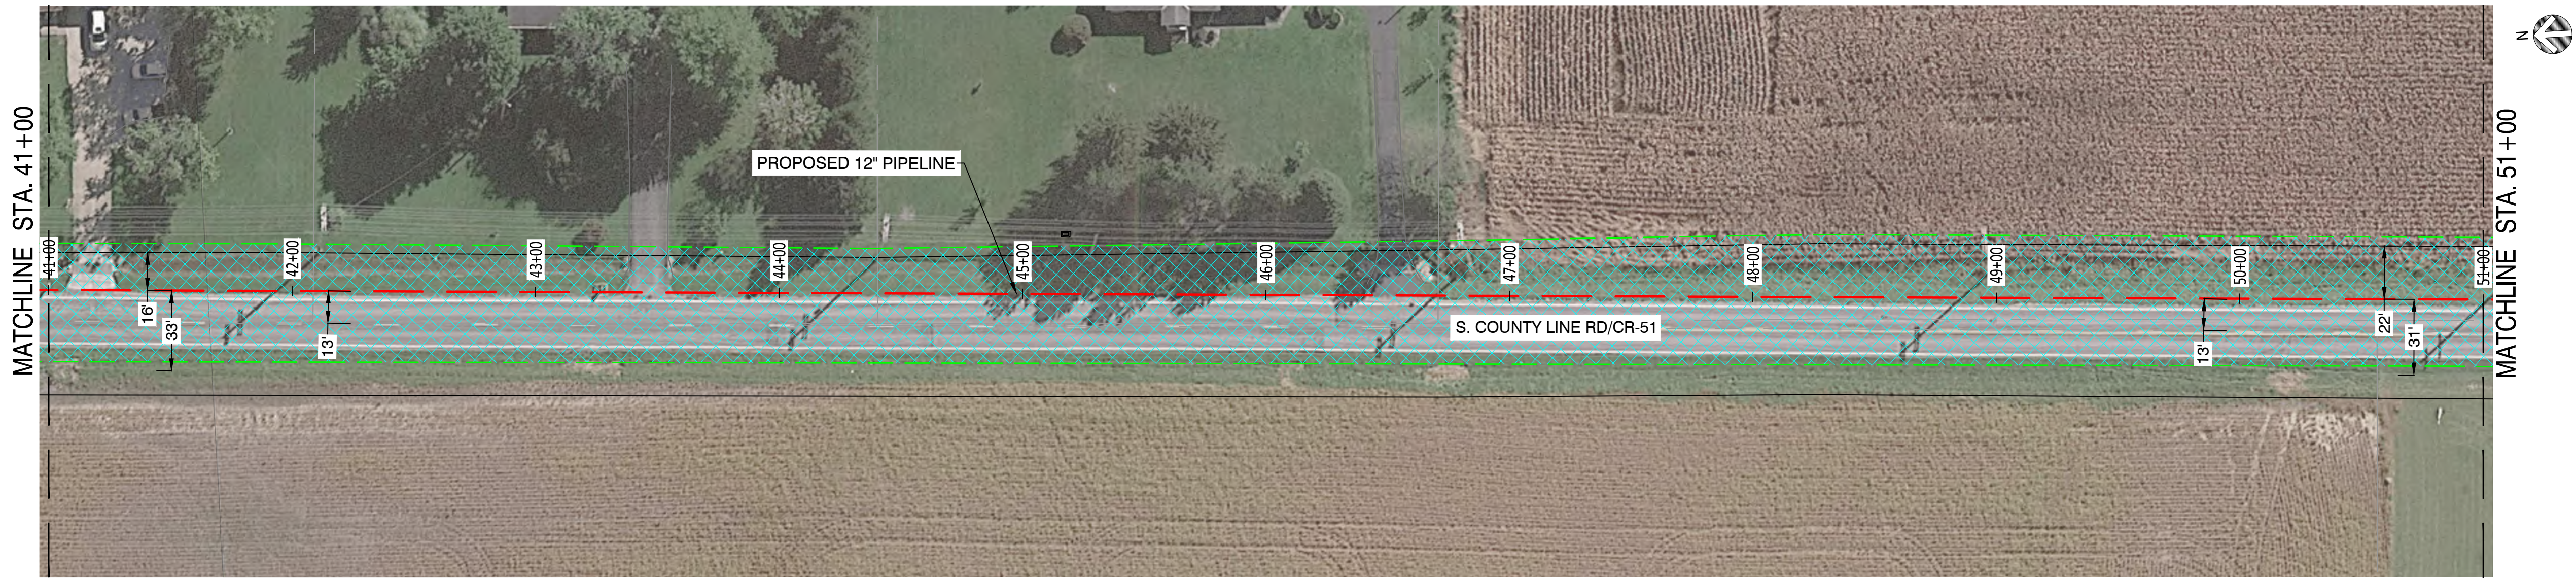


PROPOSED PLAN - 41+00 TO 51+00
(SCALE: 1" = 40')



PROPOSED PLAN - 51+00 TO 61+00
(SCALE: 1" = 40')

NOTE:
1. AERIAL IMAGERY IS FOR REFERENCE ONLY

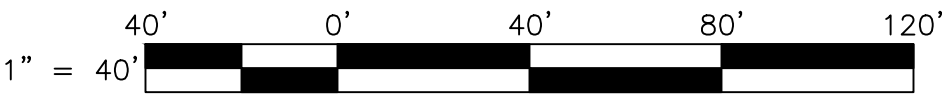

NiSource

Ohio Utilities Protection Service
Call 811
before you dig



6/9/2023

CAMPOS
EPC
200 W Adams, Suite 400, Chicago, IL 60606
(708) 505-5313

PROPOSED

REVISIONS			
REV. #	DATE	DESCRIPTION	
2	06/09/23	REVISED FOR DOT COMMENT	
1	05/05/23	UPDATED INST#	
0	03/17/23	ISSUED FOR CONSTRUCTION	

DESIGNED BY	J. JORDAN	03/17/23	708-505-5313
DRAWN BY	A. McMICHAEL	03/17/23	708-505-5313
CHECKED BY	S. WACH	03/17/23	708-505-5313
AS-BUILT BY			
NAME		DATE	PHONE #


SITE NAME:
INST# 23-0083545-00 & 23-0083546-00
PROJECT ID# 21-85257
INTEL PROJECT SLICE
NEW ALBANY, LICKING COUNTY, OH

DRAWING TITLE:
EASEMENT & WORKSPACE
STA 41+00 TO STA 61+00

DRAWING NO:
L-102




PROPOSED PLAN - 61+00 TO 71+00
(SCALE: 1" = 40')

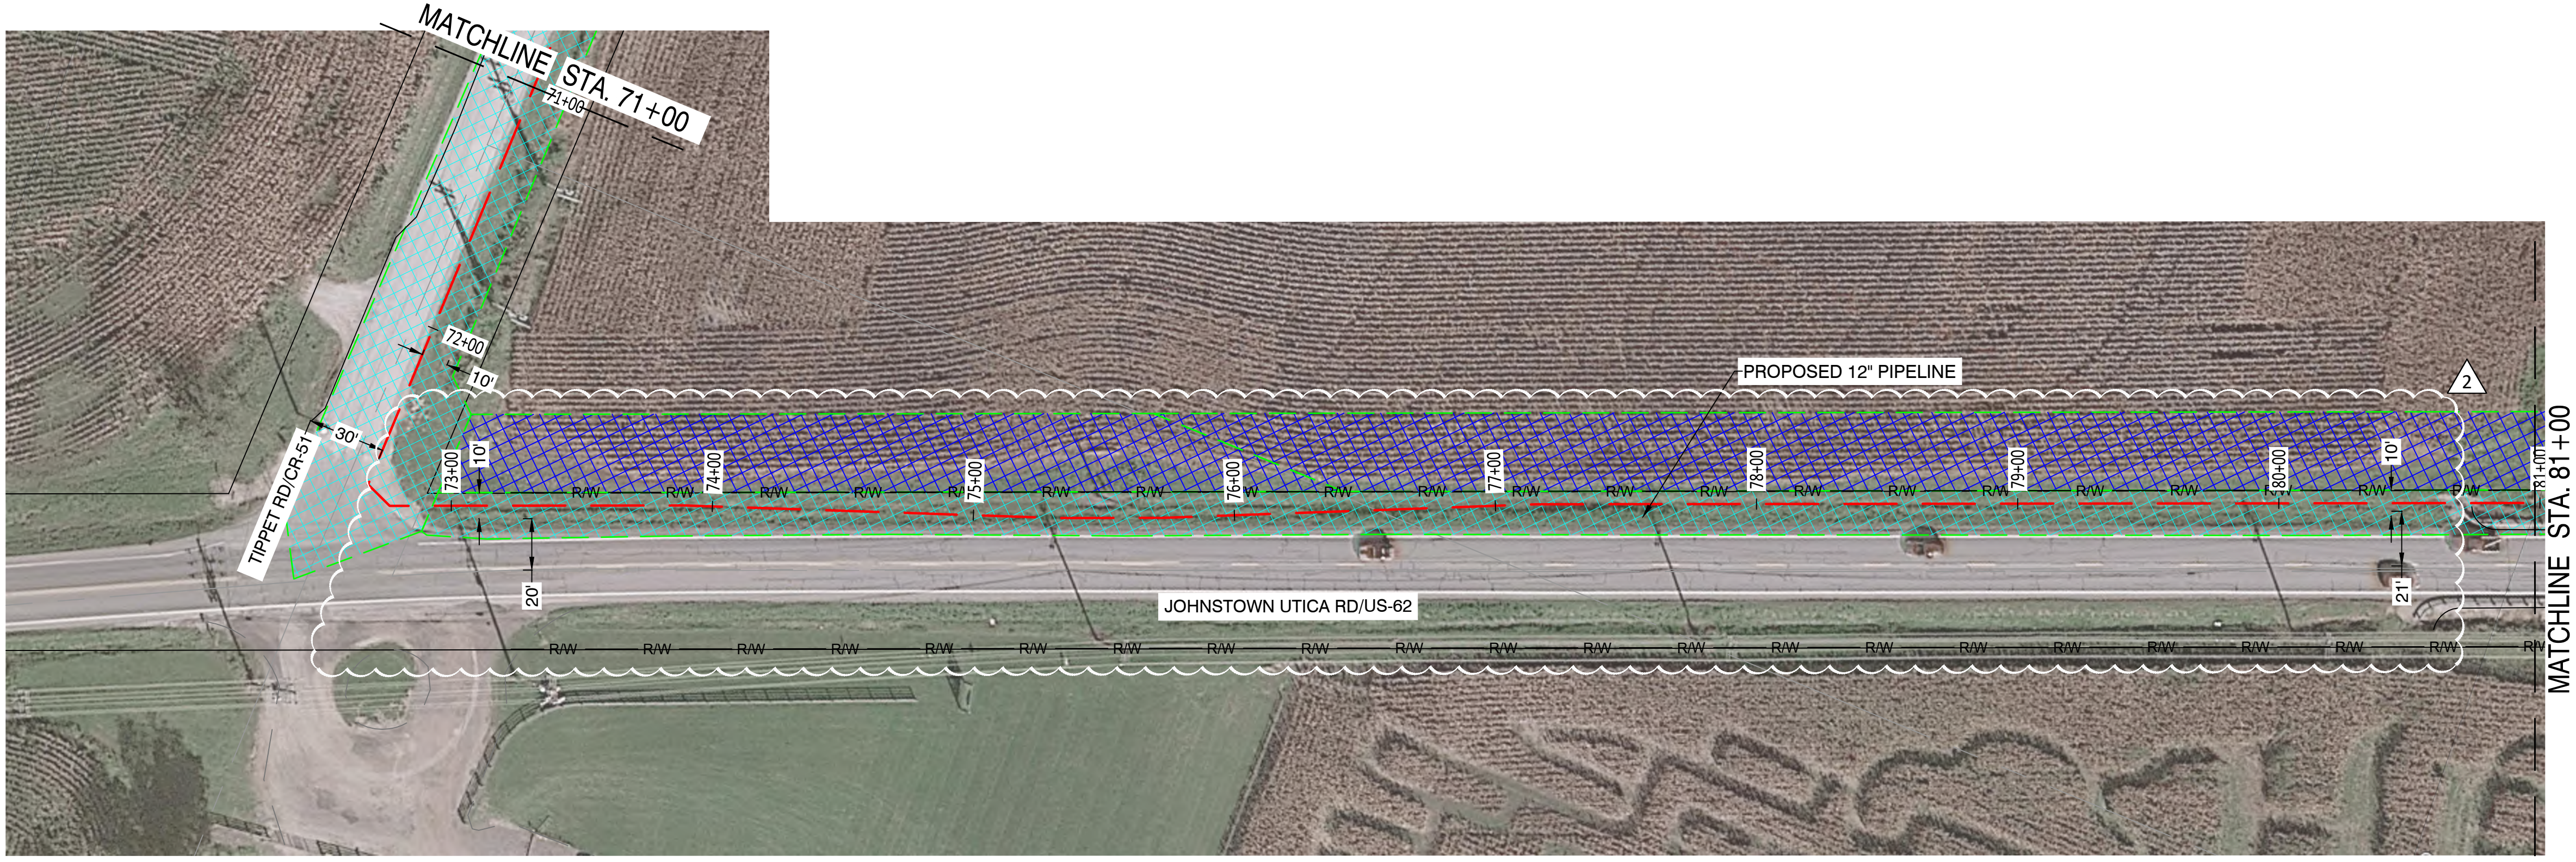

PROPOSED PLAN - 71+00 TO 81+00
(SCALE: 1" = 40')

- NOTES:
1. AERIAL IMAGERY IS FOR REFERENCE ONLY
 2. WORKSPACE WITHIN US-62 RIGHT-OF-WAY IS TO EXTEND FROM R.O.W. LINE TO EDGE OF PAVEMENT
 3. TEMPORARY WORKSPACE AND ADDITIONAL TEMPORARY WORKSPACE ON PRIVATE PROPERTY ARE ALSO SHOWN ON PLANS

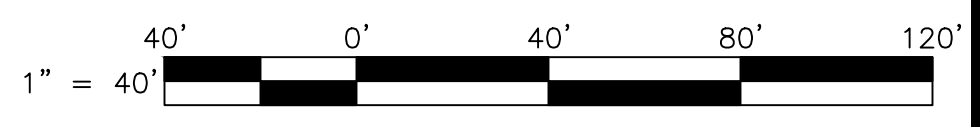

NiSource

Ohio Utilities Protection Service
Call 811
before you dig



6/9/2023

CAMPOS
EPC

200 W Adams, Suite 400, Chicago, IL 60606
(708) 505-5313

PROPOSED


REVISIONS			
REV. #	DATE	DESCRIPTION	
2	06/09/23	REVISED FOR DOT COMMENT	
1	05/05/23	UPDATED INST# : ODOT COMMENTS	
0	03/17/23	ISSUED FOR CONSTRUCTION	

DESIGNED BY	J. JORDAN	03/17/23	708-505-5313
DRAWN BY	A. McMICHAEL	03/17/23	708-505-5313
CHECKED BY	S. WACH	03/17/23	708-505-5313
AS-BUILT BY			
NAME		DATE	PHONE #


SITE NAME:
INST# 23-0083545-00 & 23-0083546-00
PROJECT ID# 21-85257
INTEL PROJECT SLICE
NEW ALBANY, LICKING COUNTY, OH

DRAWING TITLE:
EASEMENT & WORKSPACE
STA 61+00 TO 81+00

DRAWING NO:
L-103

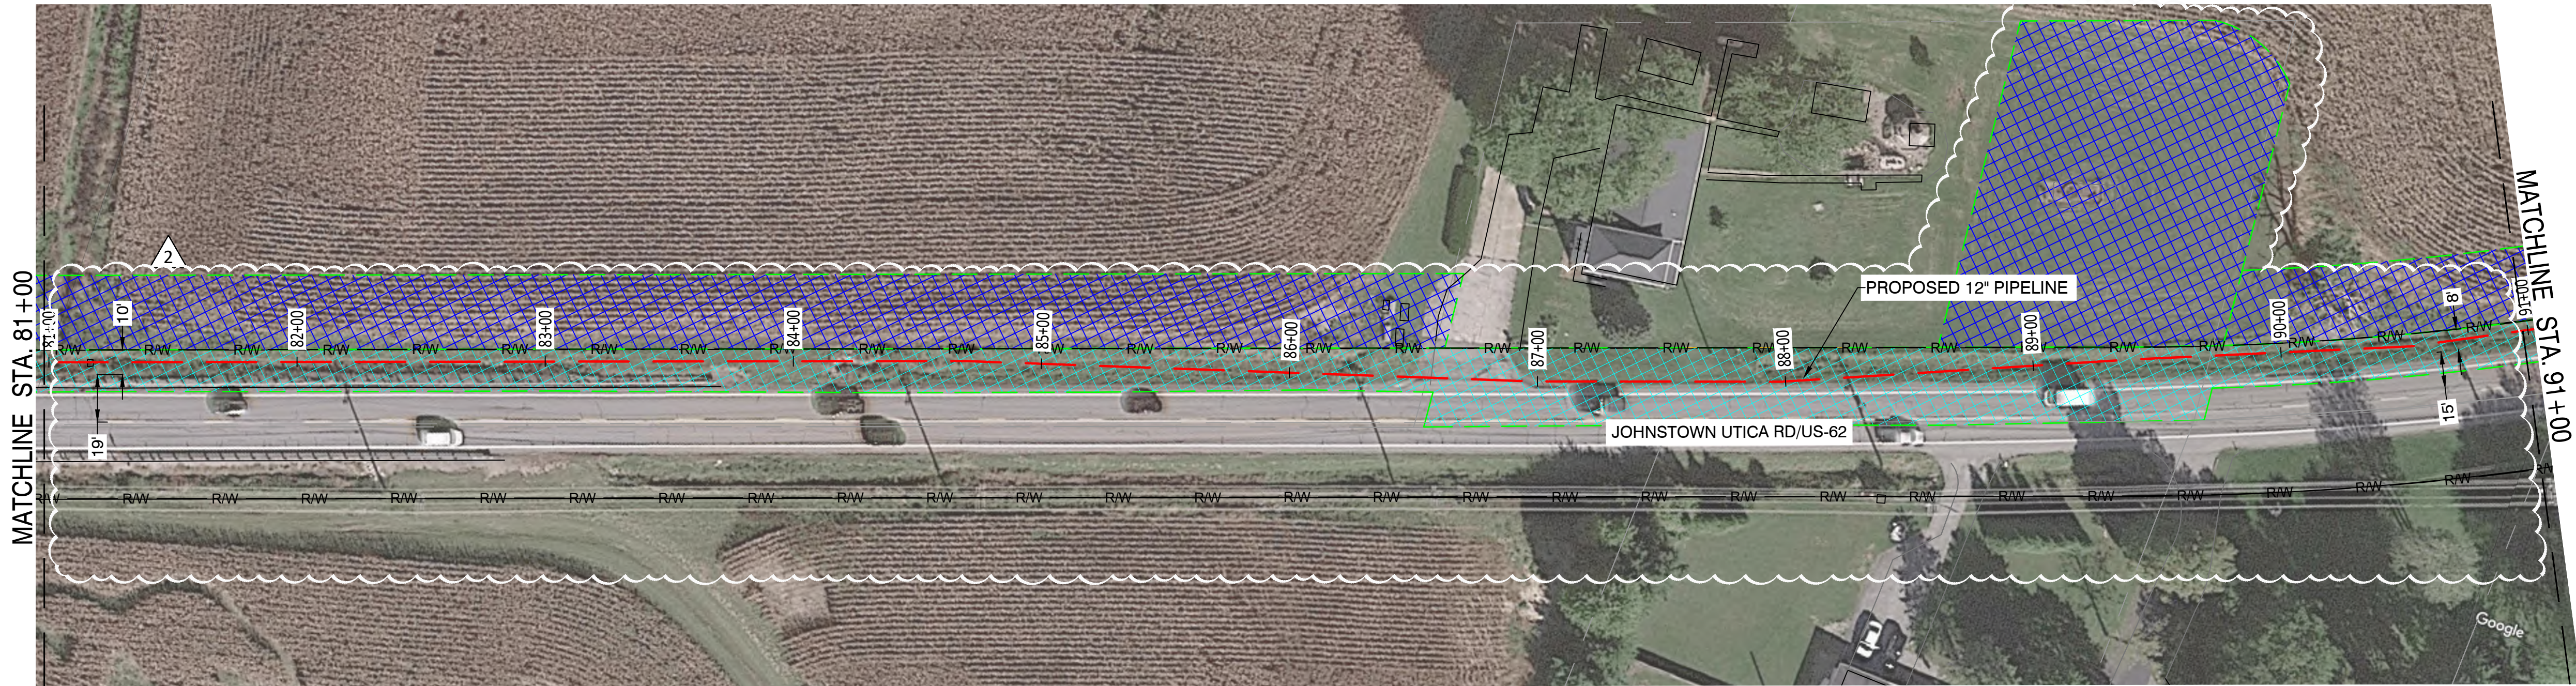

PROPOSED PLAN - 81+00 TO 91+00
(SCALE: 1" = 40')

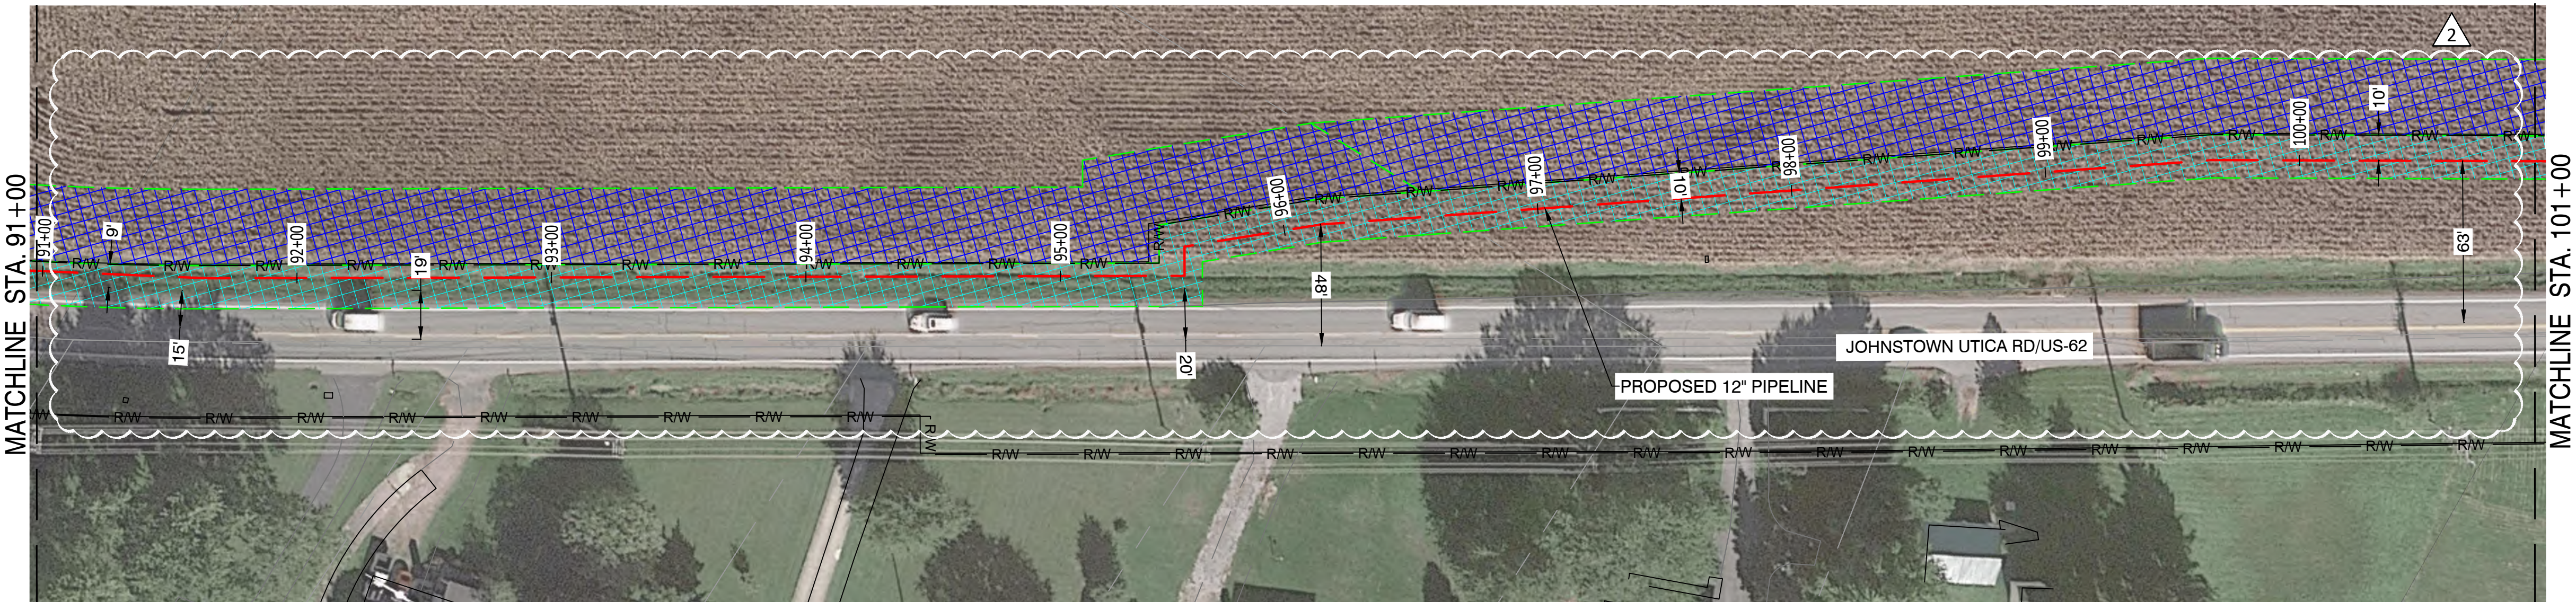

PROPOSED PLAN - 91+00 TO 101+00
(SCALE: 1" = 40')

- NOTES:
1. AERIAL IMAGERY IS FOR REFERENCE ONLY
 2. WORKSPACE WITHIN US-62 RIGHT-OF-WAY IS TO EXTEND FROM R.O.W. LINE TO EDGE OF PAVEMENT
 3. TEMPORARY WORKSPACE AND ADDITIONAL TEMPORARY WORKSPACE ON PRIVATE PROPERTY ARE ALSO SHOWN ON PLANS



NiSource

Ohio Utilities Protection Service
Call 811
before you dig



6/9/2023

CAMPOS
EPC
200 W Adams, Suite 400, Chicago, IL 60606
(708) 505-5313

PROPOSED

REVISIONS			
REV. #	DATE	DESCRIPTION	
2	06/09/23	REVISED FOR DOT COMMENT	
1	05/05/23	UPDATED INST#: ODOT COMMENTS	
0	03/17/23	ISSUED FOR CONSTRUCTION	
DESIGNED BY	J. JORDAN	03/17/23	708-505-5313
DRAWN BY	A. McMICHAEL	03/17/23	708-505-5313
CHECKED BY	S. WACH	03/17/23	708-505-5313
AS-BUILT BY			
NAME		DATE	PHONE #

SITE NAME:
INST# 23-0083545-00 & 23-0083546-00
PROJECT ID# 21-85257
INTEL PROJECT SLICE
NEW ALBANY, LICKING COUNTY, OH

DRAWING TITLE:
EASEMENT & WORKSPACE
STA 81+00 TO STA 101+00

DRAWING NO:
L-104



6/9/2023



200 W Adams, Suite 400, Chicago, IL 60606
(708) 505-5313

PROPOSED

REVISIONS

REV. #	DATE	DESCRIPTION
2	06/09/23	REVISED FOR DOT COMMENT
1	05/05/23	UPDATED INST#: PERMIT COMMENTS
0	03/17/23	ISSUED FOR CONSTRUCTION

DESIGNED BY	J. JORDAN	03/17/23	708-505-5313
DRAWN BY	A. McMICHAEL	03/17/23	708-505-5313
CHECKED BY	S. WACH	03/17/23	708-505-5313
AS-BUILT BY			
	NAME	DATE	PHONE #

SITE NAME:

INST# 23-0083545-00 &
23-0083546-00


PROJECT ID# 21-85257
INTEL PROJECT SLICE
NEW ALBANY, LICKING COUNTY, OH

DRAWING TITLE:


EASEMENT & WORKSPACE
STA 101+00 TO STA 121+00

DRAWING NO:

L-105

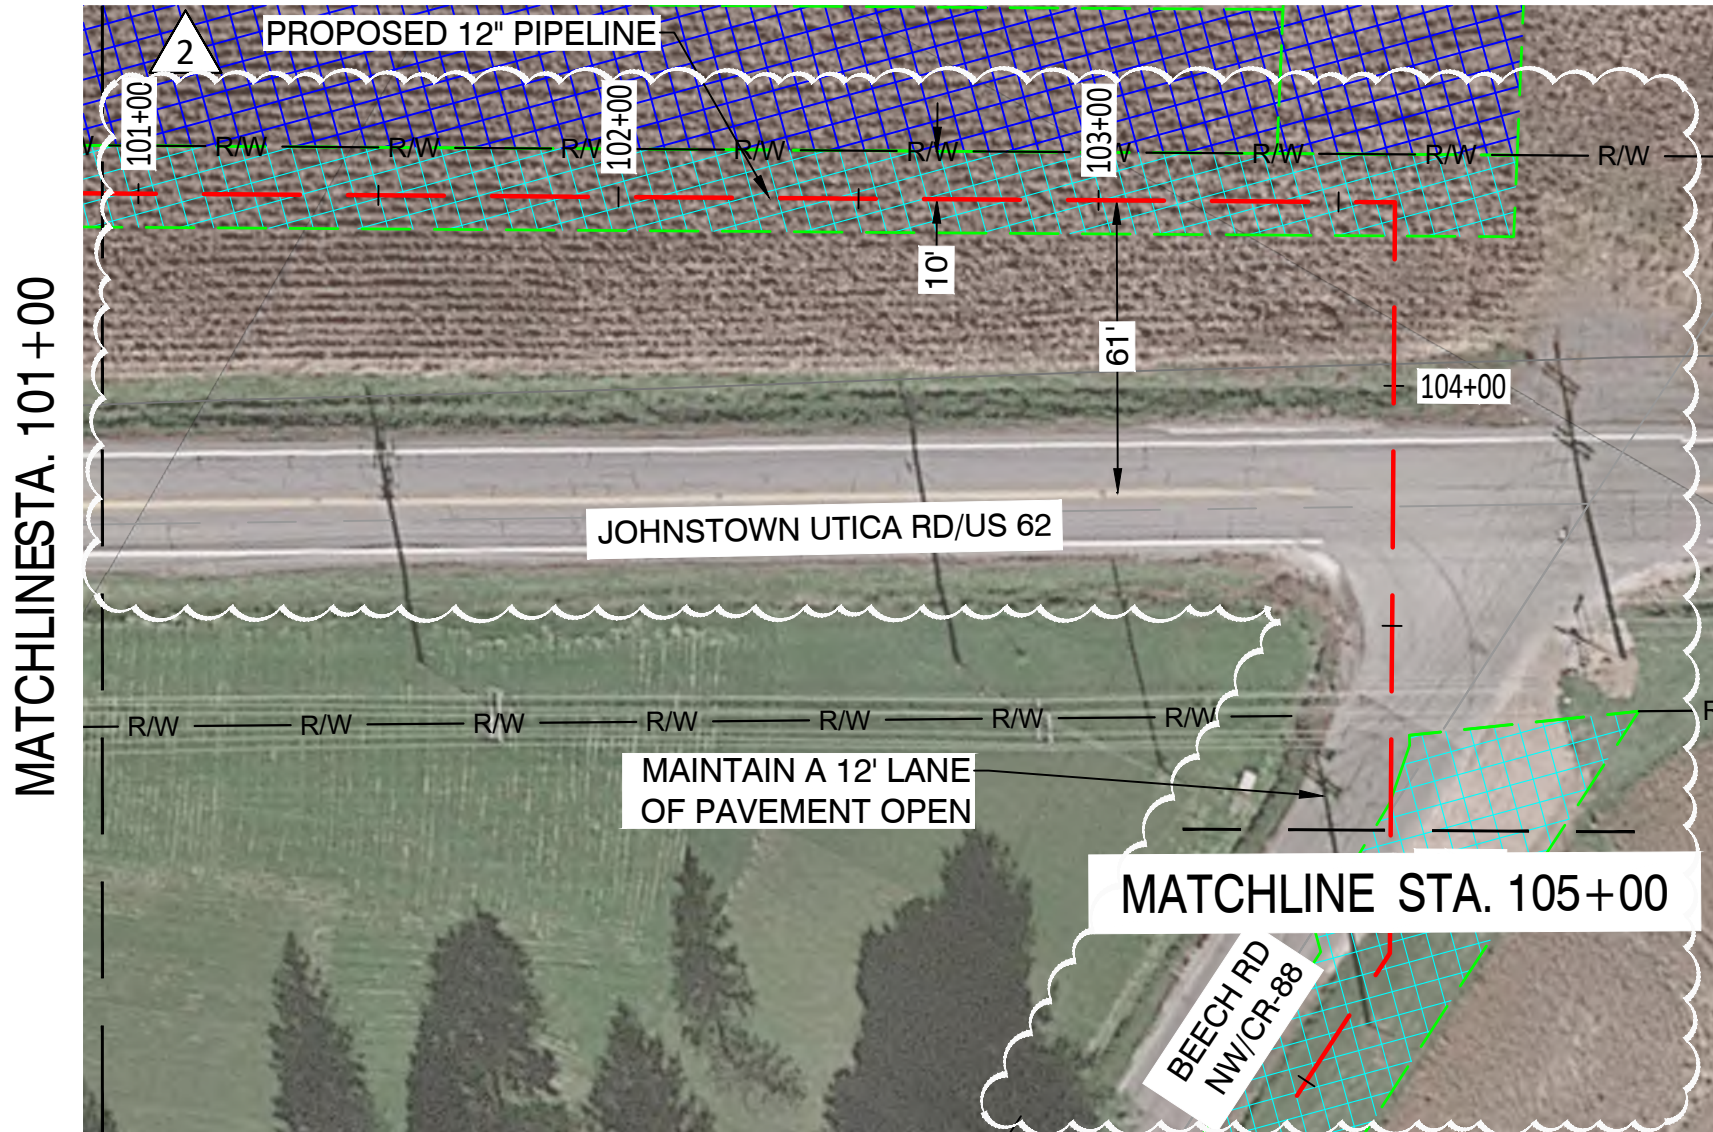

PROPOSED PLAN - 101+00 TO 111+00
(SCALE: 1" = 40')

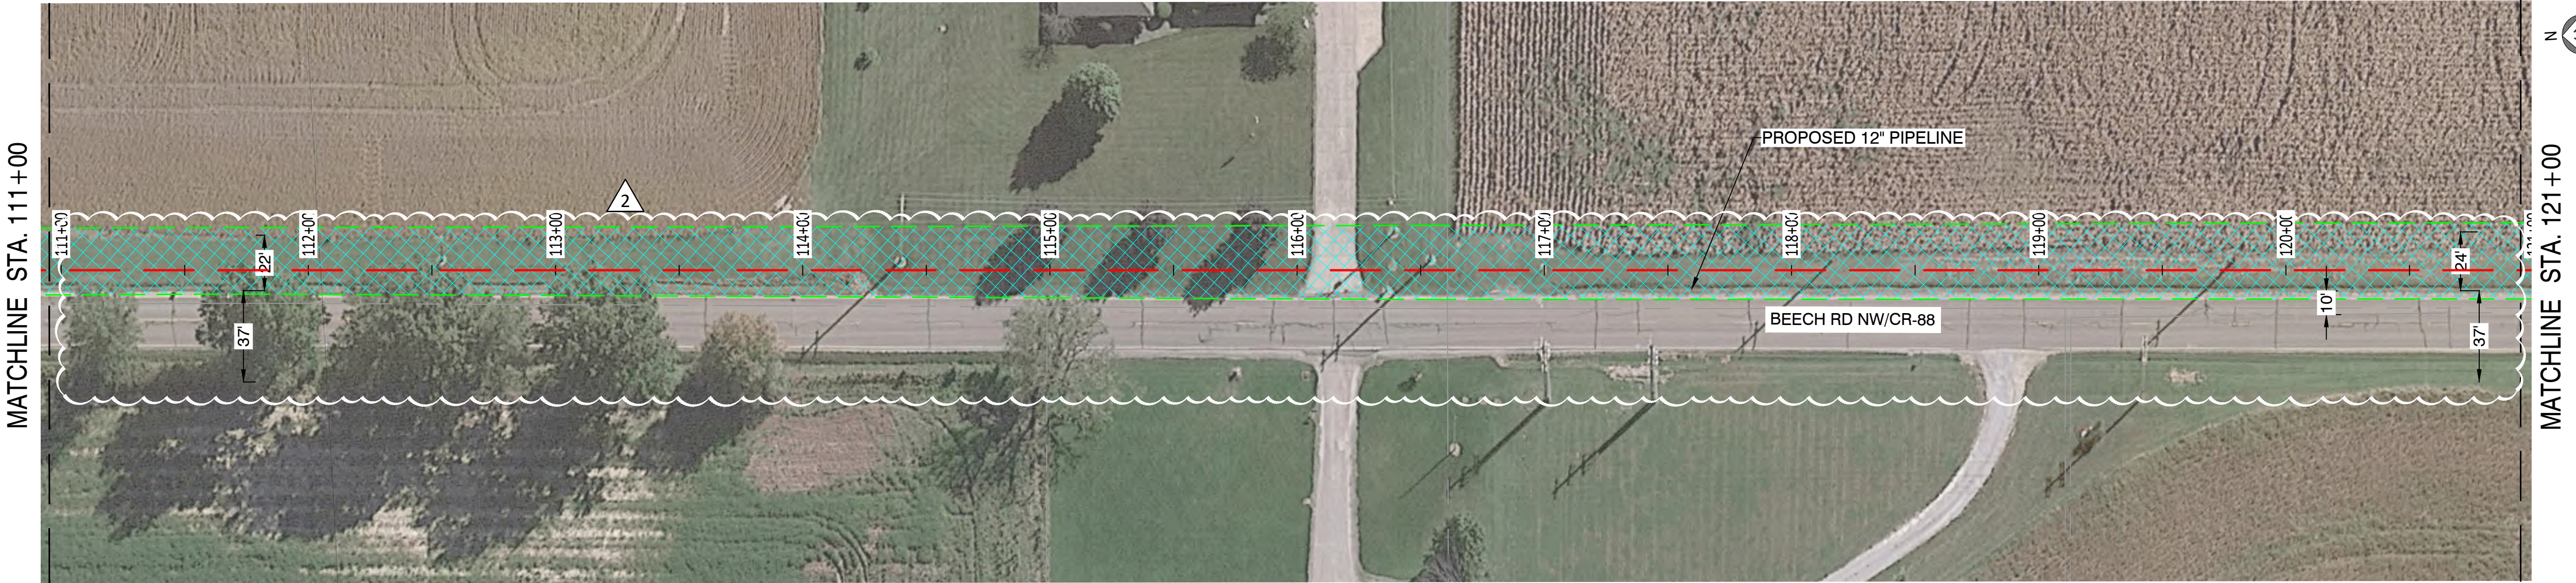

PROPOSED PLAN - 111+00 TO 121+00
(SCALE: 1" = 40')


2

- NOTES:
- AERIAL IMAGERY IS FOR REFERENCE ONLY
 - WORKSPACE WITHIN BEECH ROAD RIGHT-OF-WAY IS TO CENTERLINE OF THE ROAD UNLESS NOTED OTHERWISE

1" = 40'



PROPOSED PLAN - 121+00 TO 131+00
(SCALE: 1" = 40')


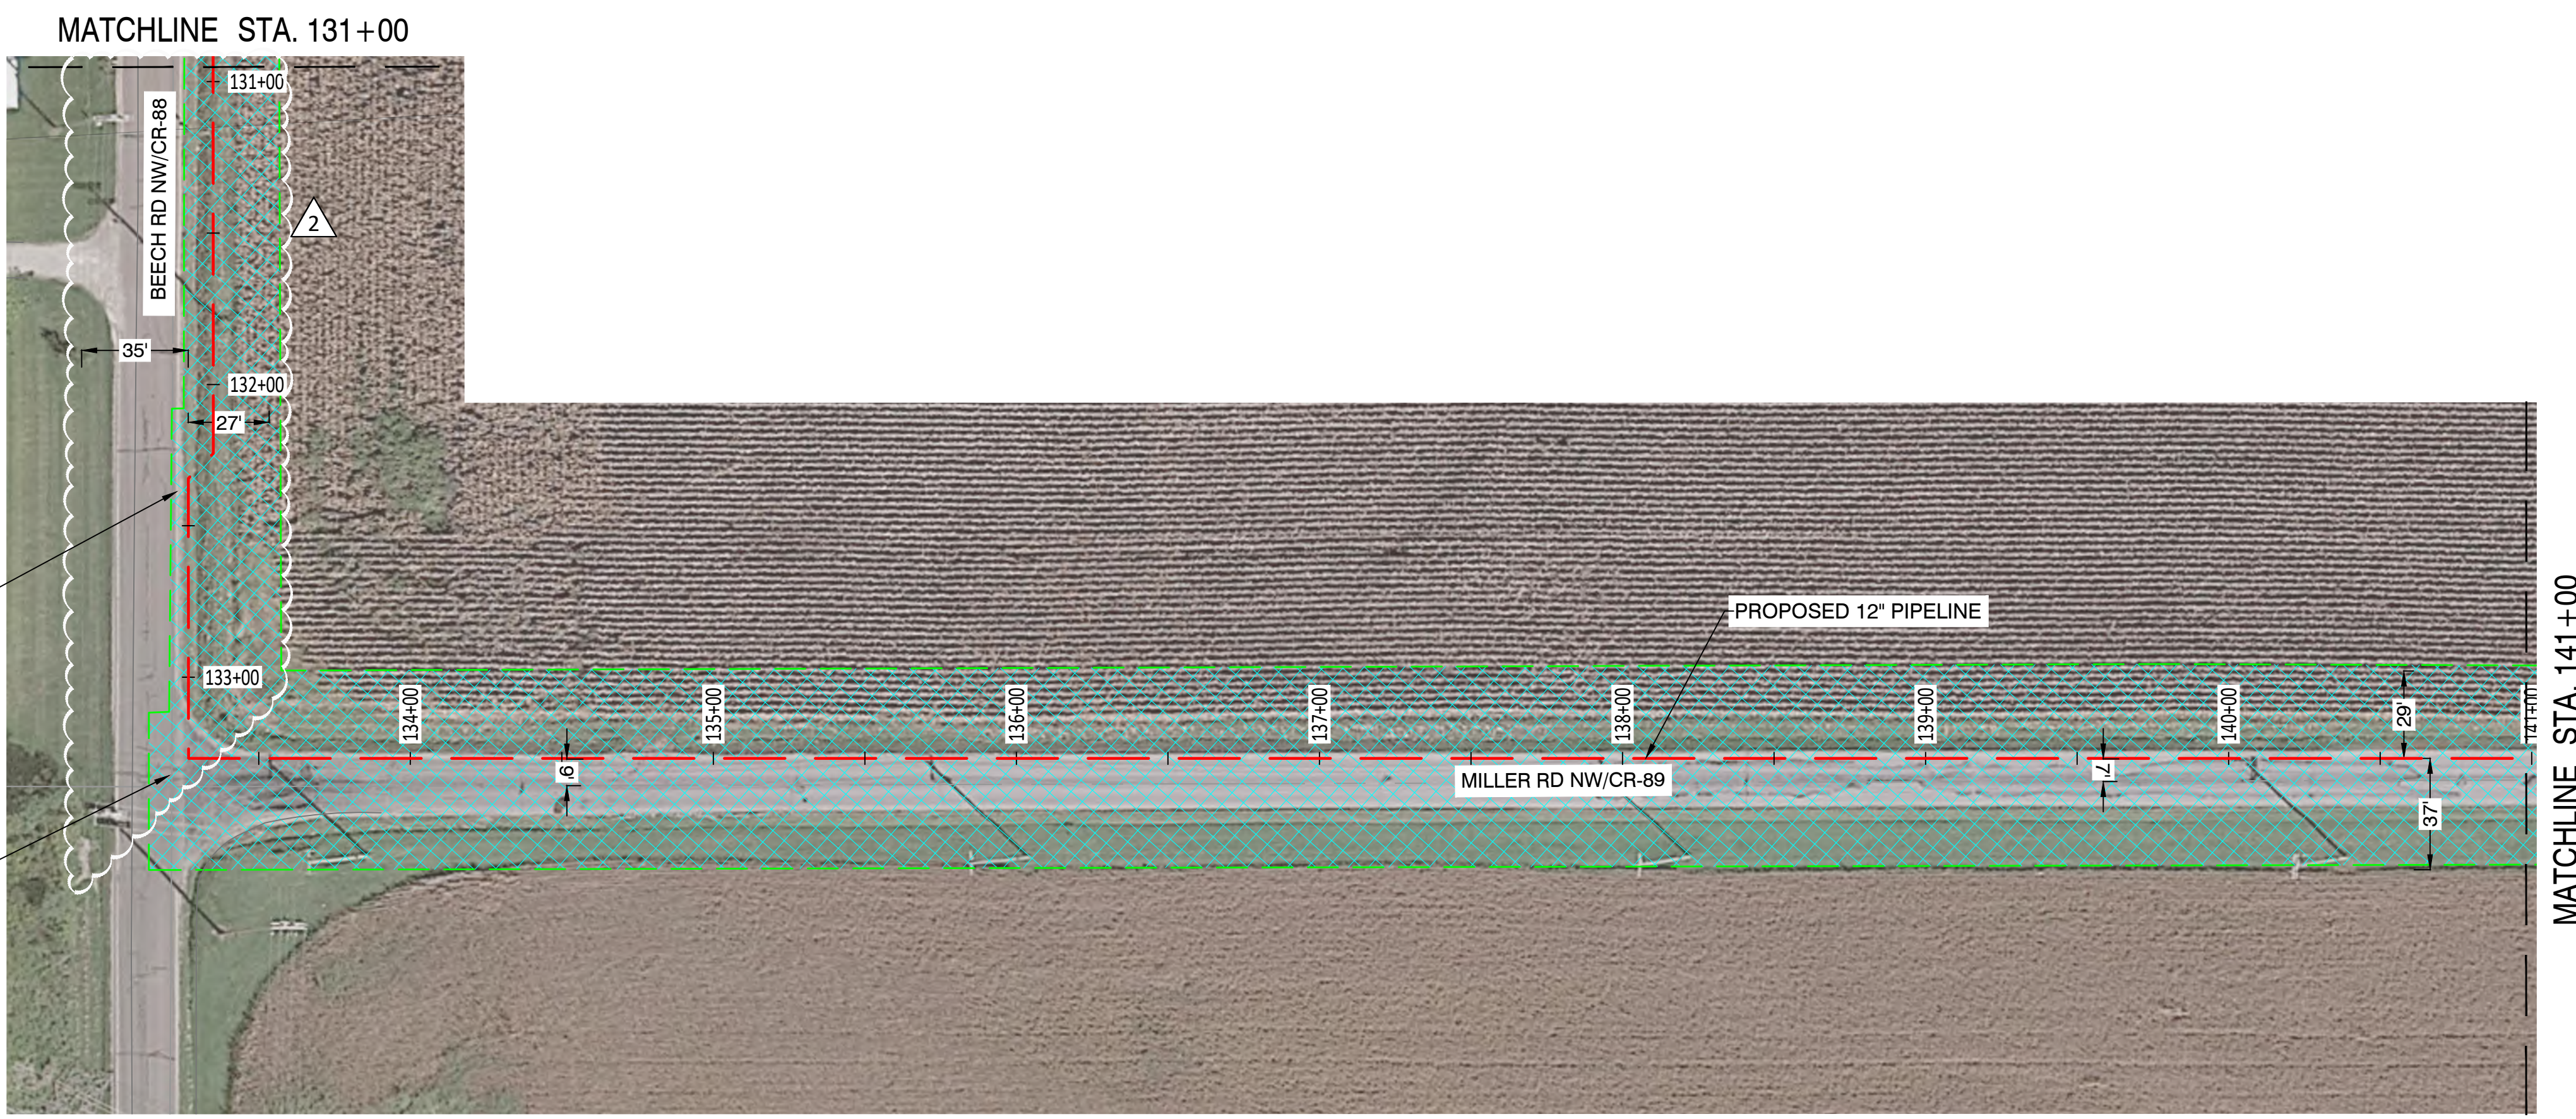


PROPOSED PLAN - 131+00 TO 141+00
(SCALE: 1" = 40')

MAINTAIN A MINIMUM 24" FROM PAVEMENT OPEN WHERE POSSIBLE

MAINTAIN A MINIMUM 12" FROM PAVEMENT OPEN WHERE POSSIBLE

- NOTES:
1. AERIAL IMAGERY IS FOR REFERENCE ONLY
 2. WORKSPACE WITHIN BEECH ROAD RIGHT-OF-WAY IS TO CENTERLINE OF THE ROAD UNLESS NOTED OTHERWISE

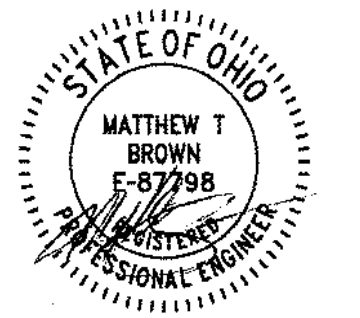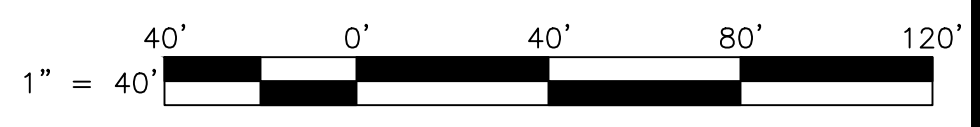

6/9/2023



200 W Adams, Suite 400, Chicago, IL 60606
(708) 505-5313

PROPOSED

REVISIONS			
REV. #	DATE	DESCRIPTION	
2	06/09/23	REVISED FOR DOT COMMENT	
1	05/05/23	UPDATED INST#; PERMIT COMMENTS	
0	03/17/23	ISSUED FOR CONSTRUCTION	
DESIGNED BY	J. JORDAN	03/17/23	708-505-5313
DRAWN BY	A. McMICHAEL	03/17/23	708-505-5313
CHECKED BY	S. WACH	03/17/23	708-505-5313
AS-BUILT BY			
NAME		DATE	PHONE #

SITE NAME:
INST# 23-0083545-00 & 23-0083546-00
PROJECT ID# 21-85257
INTEL PROJECT SLICE
NEW ALBANY, LICKING COUNTY, OH

DRAWING TITLE:
EASEMENT & WORKSPACE
STA 121+00 TO STA 141+00

DRAWING NO:
L-106



6/9/2023



PROPOSED

REVISIONS			
2	06/09/23	REVISED FOR DOT COMMENT	
1	05/05/23	UPDATED INST#	
0	03/17/23	ISSUED FOR CONSTRUCTION	
REV. #	DATE	DESCRIPTION	

DESIGNED BY	J. JORDAN	03/17/23	708-505-5313
DRAWN BY	A. McMICHAEL	03/17/23	708-505-5313
CHECKED BY	S. WACH	03/17/23	708-505-5313
AS-BUILT BY			
	NAME	DATE	PHONE #


SITE NAME:
INST# 23-0083545-00 & 23-0083546-00
PROJECT ID# 21-85257
INTEL PROJECT SLICE
NEW ALBANY, LICKING COUNTY, OH

DRAWING TITLE:
EASEMENT & WORKSPACE
STA 141+00 TO STA 161+00

DRAWING NO:
L-107





PROPOSED PLAN - 141+00 TO 151+00
(SCALE: 1" = 40')

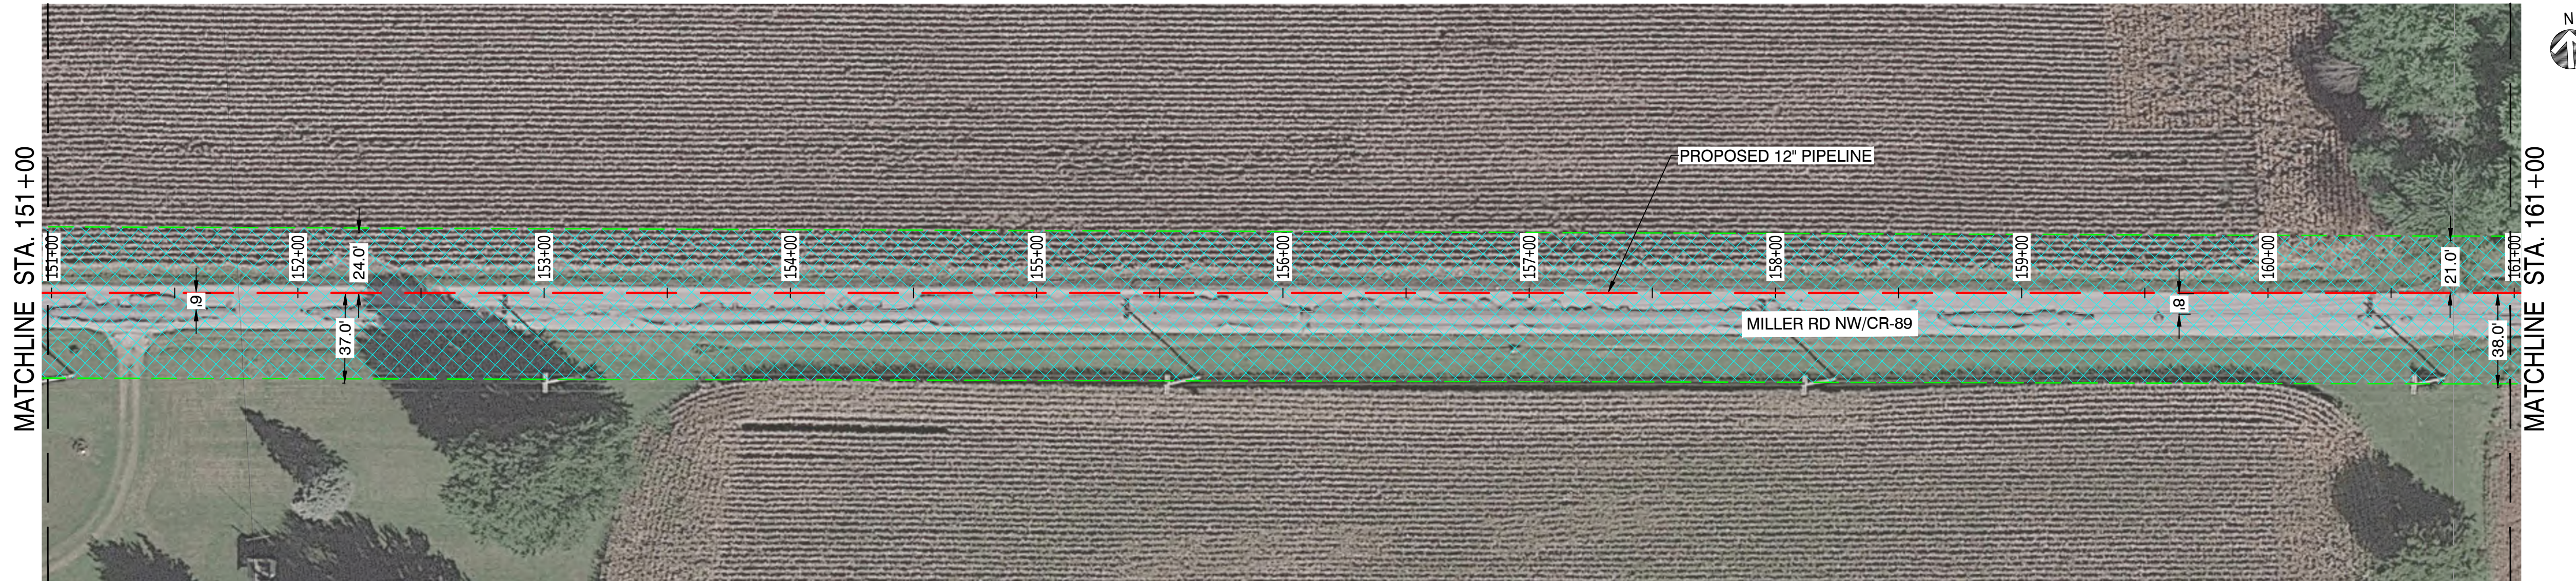


PROPOSED PLAN - 151+00 TO 161+00
(SCALE: 1" = 40')

NOTE:
1. AERIAL IMAGERY IS FOR REFERENCE ONLY


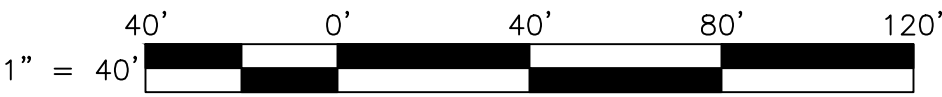


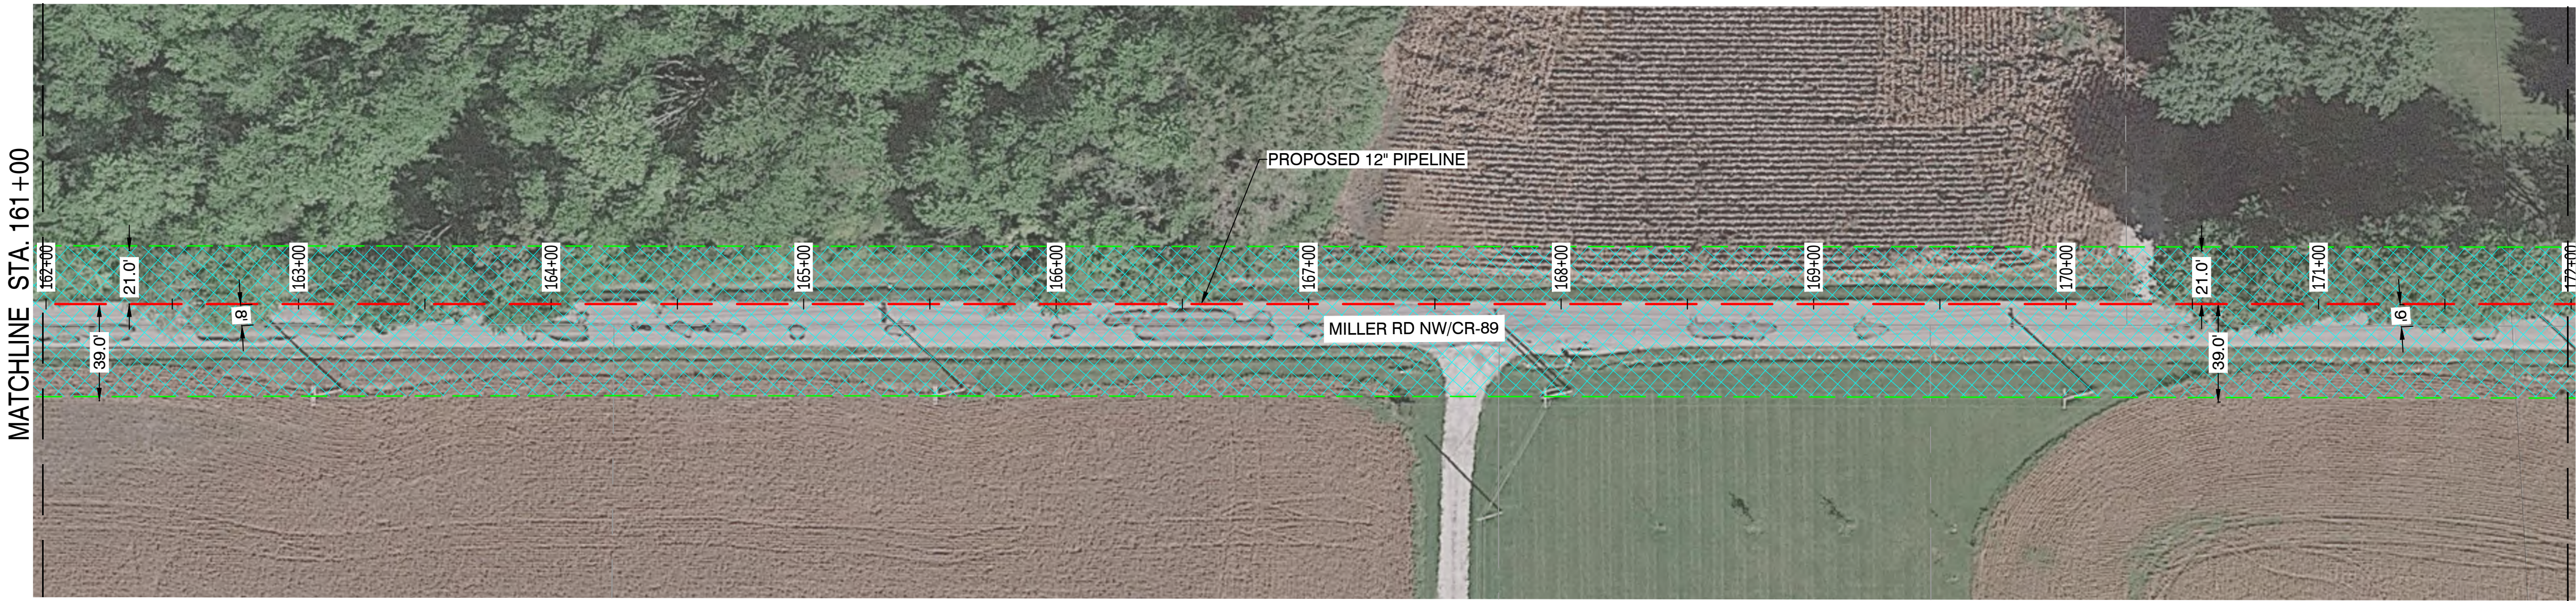

PROPOSED PLAN - 161+00 TO 171+00
(SCALE: 1" = 40')

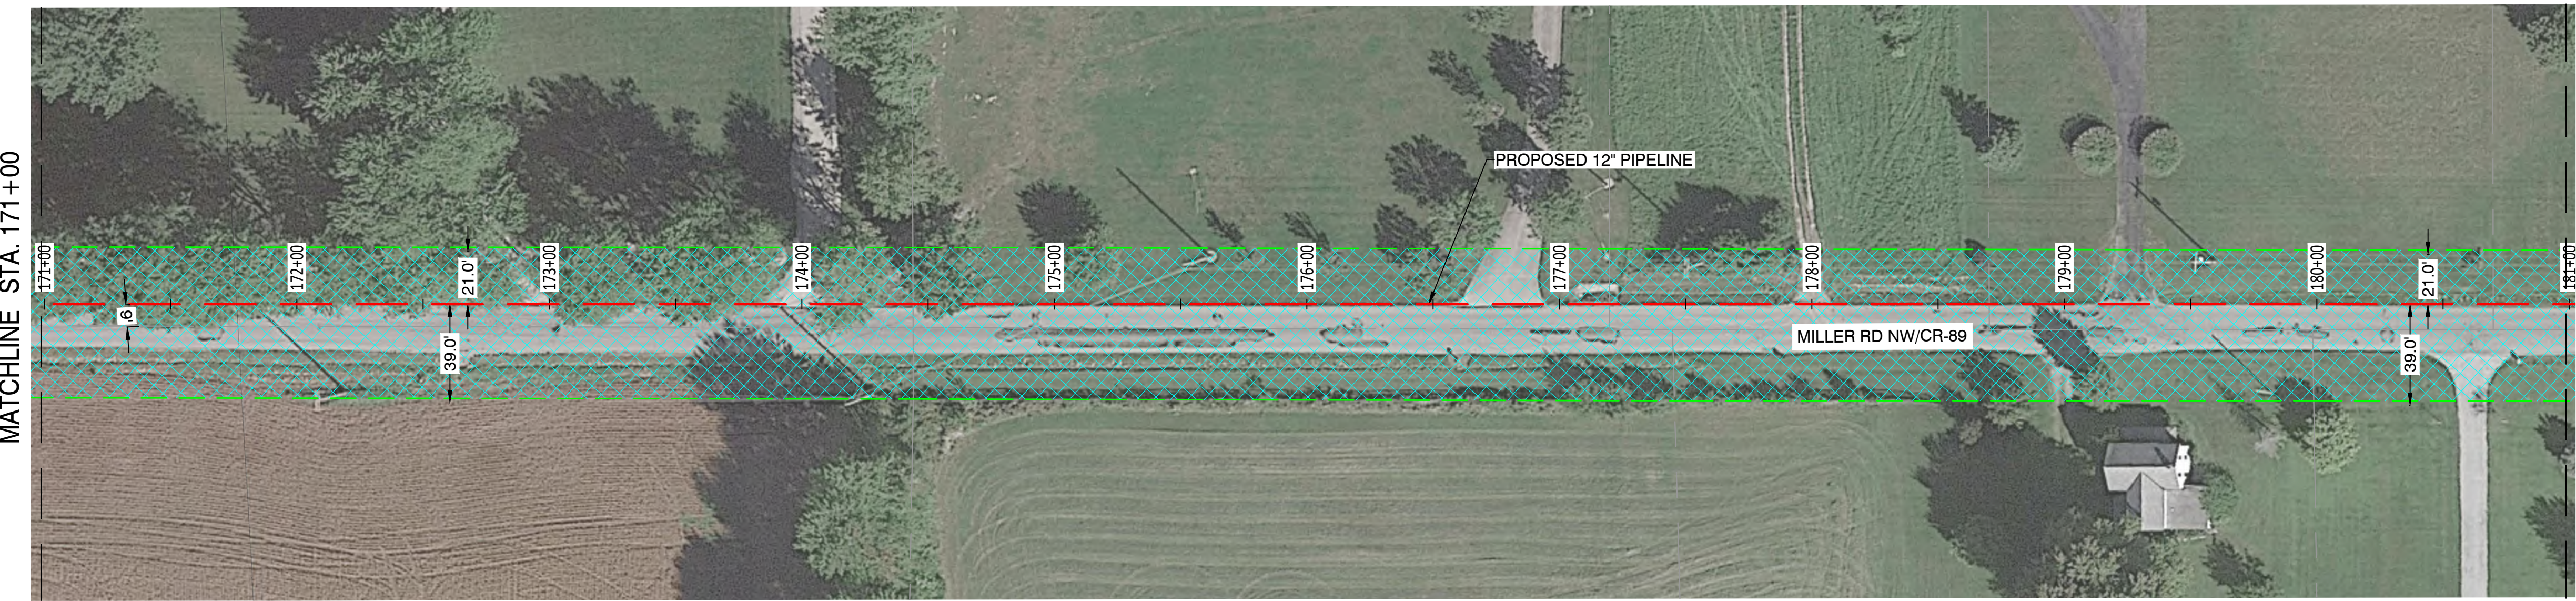

PROPOSED PLAN - 171+00 TO 181+00
(SCALE: 1" = 40')

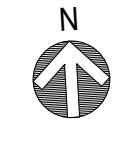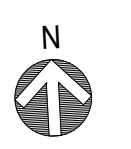

NiSource

Ohio Utilities Protection Service
Call 811
before you dig



6/9/2023

CAMPOS
EPC

200 W Adams, Suite 400, Chicago, IL 60606
(708) 505-5313

PROPOSED

REVISIONS		
REV. #	DATE	DESCRIPTION
2	06/09/23	REVISED FOR DOT COMMENT
1	05/05/23	UPDATED INST#
0	03/17/23	ISSUED FOR CONSTRUCTION

DESIGNED BY	J. JORDAN	03/17/23	708-505-5313
DRAWN BY	A. McMICHAEL	03/17/23	708-505-5313
CHECKED BY	S. WACH	03/17/23	708-505-5313
AS-BUILT BY			
NAME		DATE	PHONE #

SITE NAME:
INST# 23-0083545-00 & 23-0083546-00
PROJECT ID# 21-85257
INTEL PROJECT SLICE
NEW ALBANY, LICKING COUNTY, OH

DRAWING TITLE:
EASEMENT & WORKSPACE
STA 161+00 TO STA 181+00

DRAWING NO:
L-108

NOTE:
1. AERIAL IMAGERY IS FOR REFERENCE ONLY






PROPOSED PLAN - 181+00 TO 191+00
(SCALE: 1" = 40')



PROPOSED PLAN - 191+00 TO 201+00
(SCALE: 1" = 40')

NOTE:
1. AERIAL IMAGERY IS FOR REFERENCE ONLY

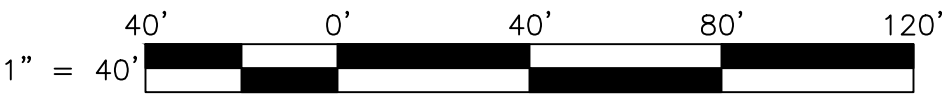

NiSource

Ohio Utilities Protection Service
Call 811
before you dig



6/9/2023

CAMPOS
EPC

200 W Adams, Suite 400, Chicago, IL 60606
(708) 505-5313

PROPOSED

REVISIONS			
REV. #	DATE	DESCRIPTION	
2	06/09/23	REVISED FOR DOT COMMENT	
1	05/05/23	UPDATED INST#	
0	03/17/23	ISSUED FOR CONSTRUCTION	

DESIGNED BY	J. JORDAN	03/17/23	708-505-5313
DRAWN BY	A. McMICHAEL	03/17/23	708-505-5313
CHECKED BY	S. WACH	03/17/23	708-505-5313
AS-BUILT BY			
	NAME	DATE	PHONE #

SITE NAME:
INST# 23-0083545-00 & 23-0083546-00
PROJECT ID# 21-85257
INTEL PROJECT SLICE
NEW ALBANY, LICKING COUNTY, OH

DRAWING TITLE:
EASEMENT & WORKSPACE
STA 181+00 TO STA 201+00

DRAWING NO:
L-109



7/7/2023


PROPOSED

REVISIONS			
REV. #	DATE	DESCRIPTION	
4	07/06/23	UPDATED FOR PROPOSED ROW	
3	06/30/23	REVISED FOR HEAVY LOAD ACCESS ROAD	
2	06/09/23	REVISED FOR DOT COMMENT	
1	05/05/23	UPDATED INST#	
0	03/17/23	ISSUED FOR CONSTRUCTION	
DESIGNED BY	J. JORDAN	03/17/23	708-505-5313
DRAWN BY	A. McMICHAEL	03/17/23	708-505-5313
CHECKED BY	S. WACH	03/17/23	708-505-5313
AS-BUILT BY			
NAME		DATE	PHONE #


SITE NAME:
INST# 23-0083545-00 & 23-0083546-00
PROJECT ID# 21-85257
INTEL PROJECT SLICE
NEW ALBANY, LICKING COUNTY, OH

DRAWING TITLE:
EASEMENT & WORKSPACE
STA 201+00 TO STA 221+00


DRAWING NO:
L-110

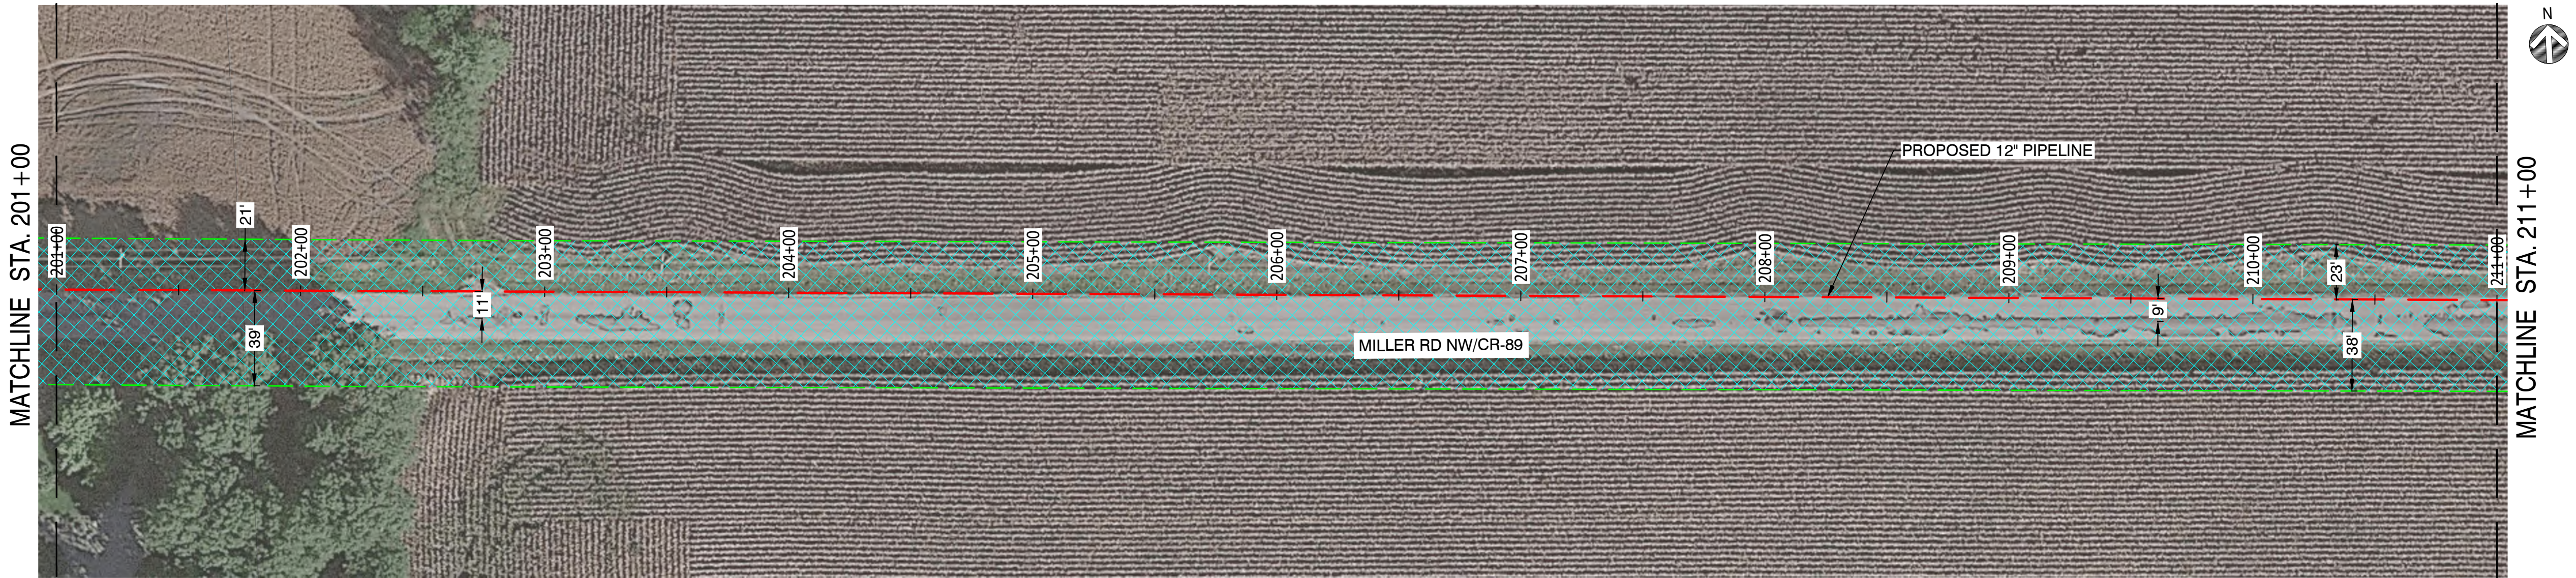


PROPOSED PLAN - 201+00 TO 211+00
(SCALE: 1" = 40')

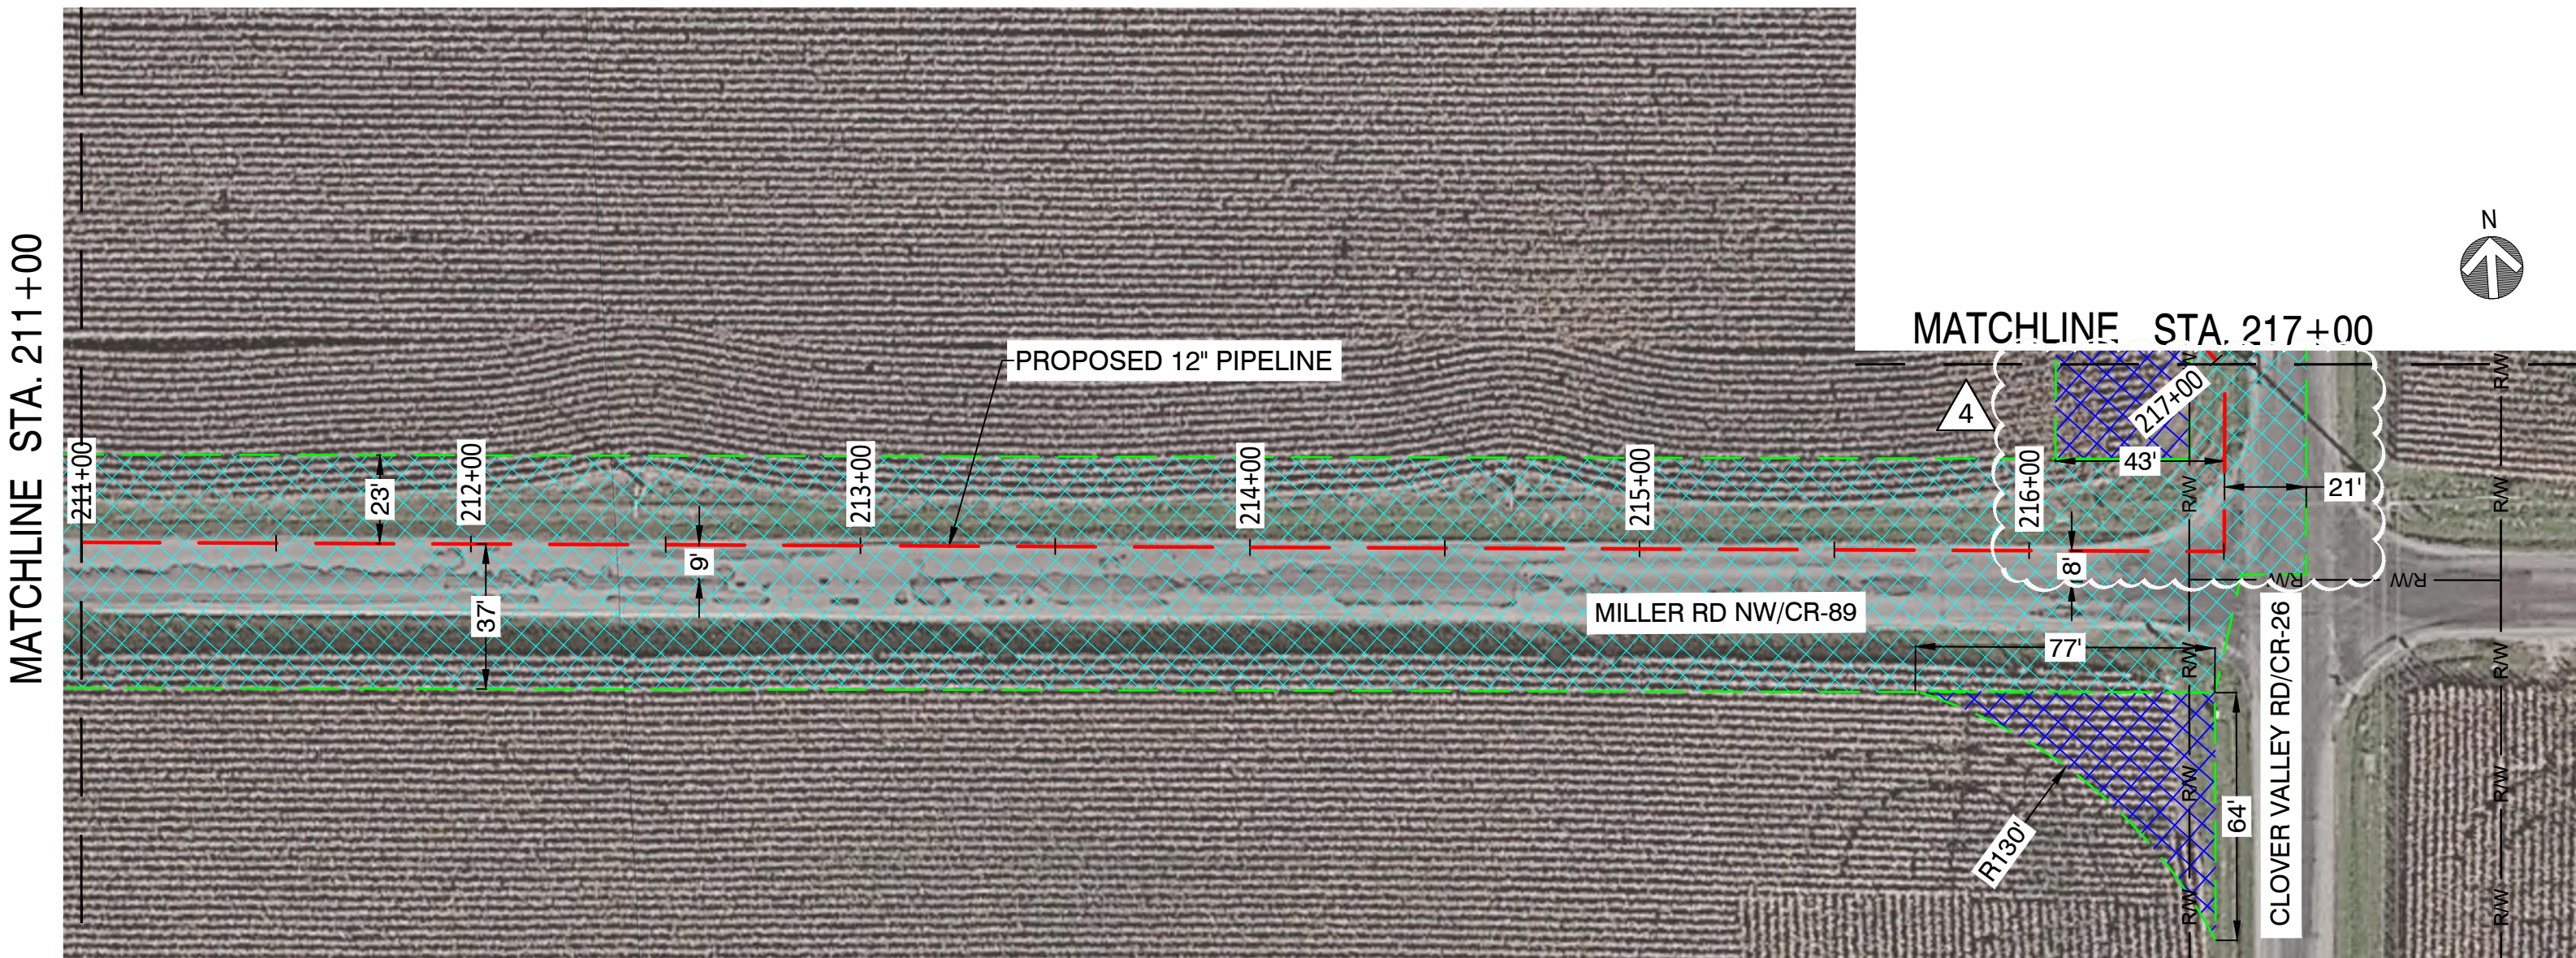


PROPOSED PLAN - 211+00 TO 221+00
(SCALE: 1" = 40')

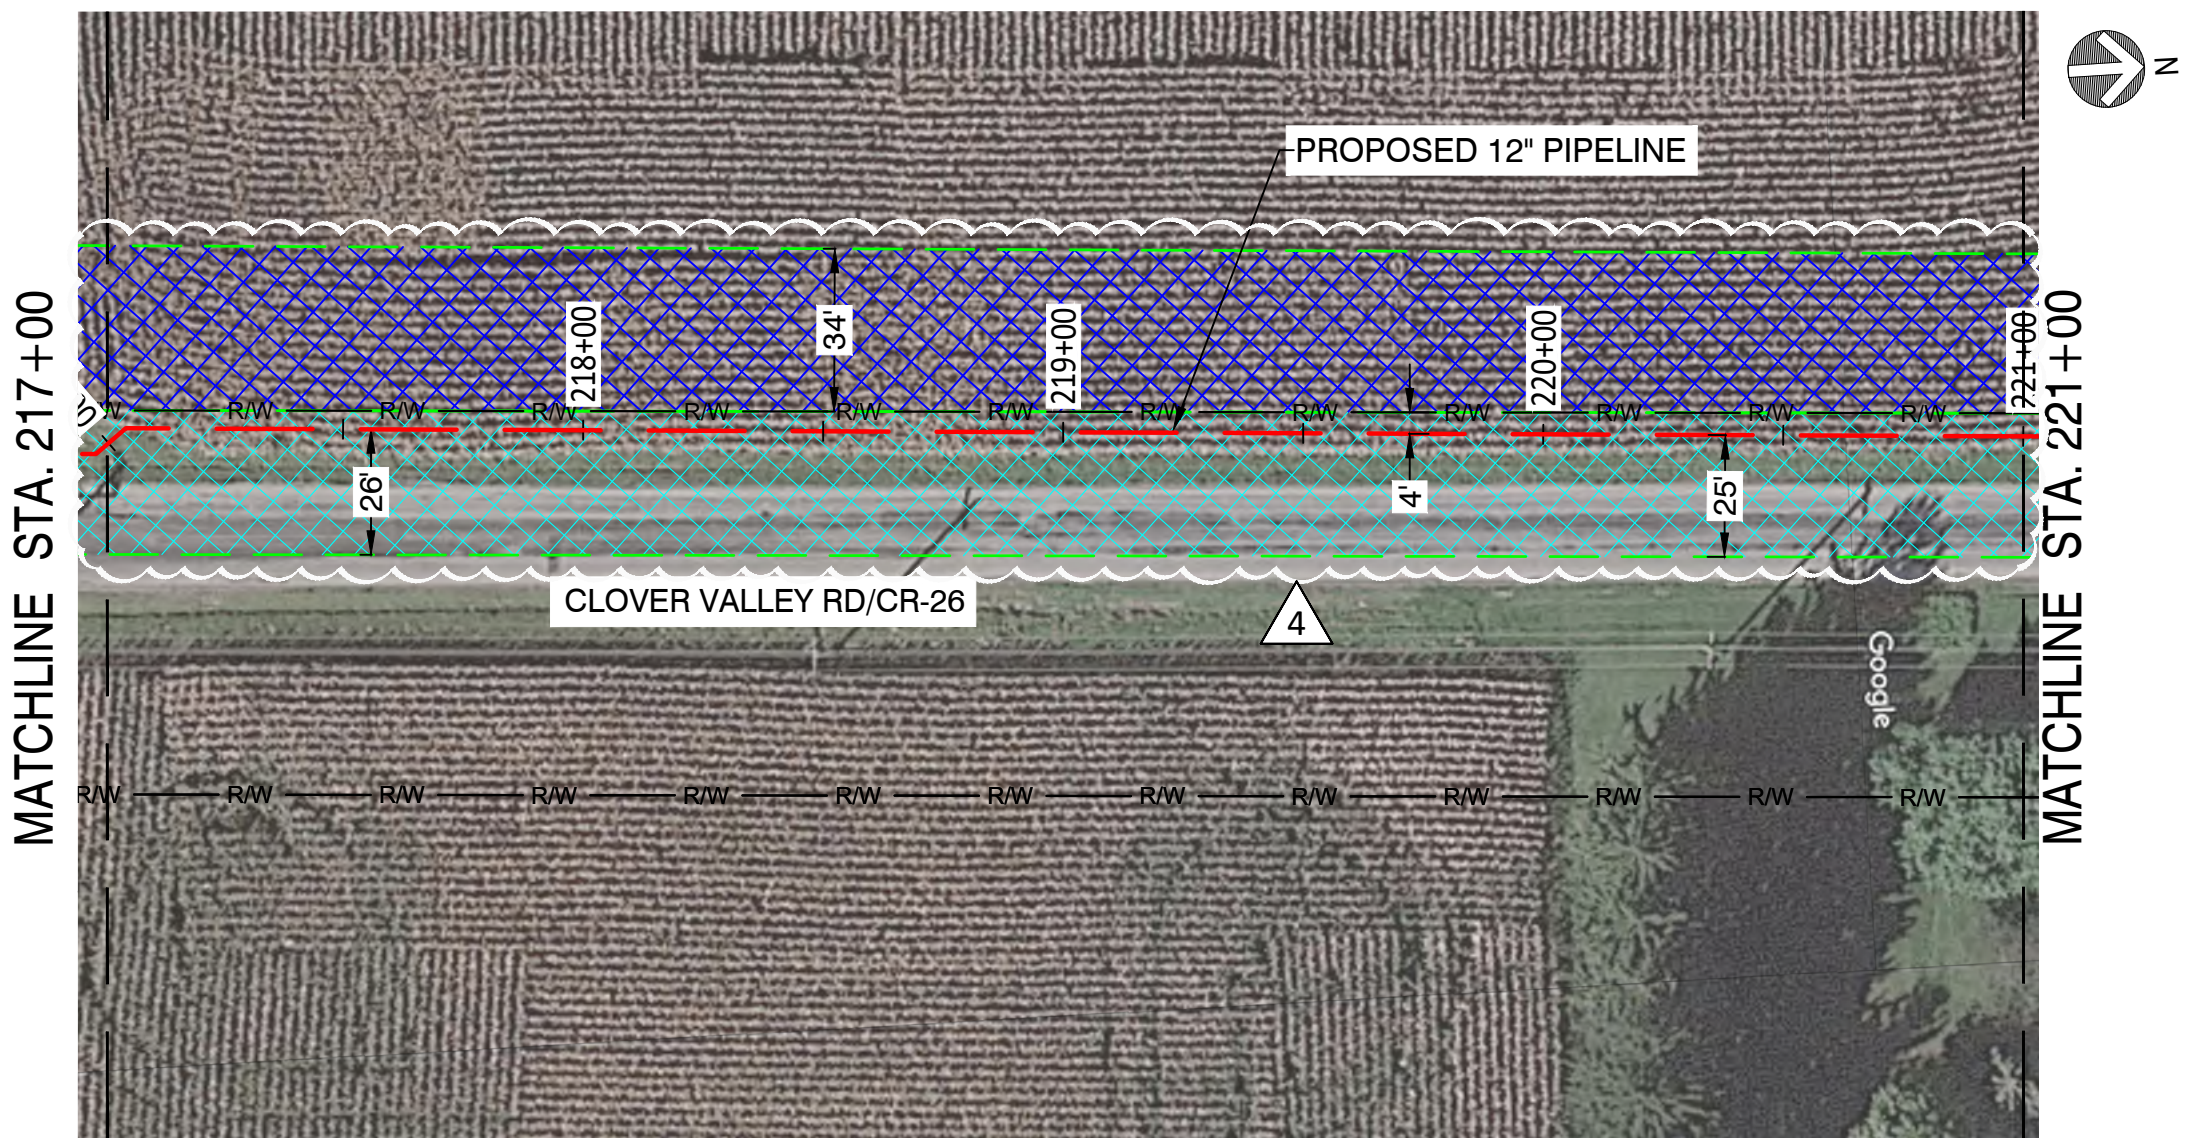


- NOTES:
1. AERIAL IMAGERY IS FOR REFERENCE ONLY
 2. WORKSPACE WITHIN CLOVER VALLEY ROAD RIGHT-OF-WAY IS TO EXTEND FROM R.O.W. LINE TO EDGE OF PAVEMENT UNLESS NOTED OTHERWISE
 3. TEMPORARY WORKSPACE AND ADDITIONAL TEMPORARY WORKSPACE ON PRIVATE PROPERTY ARE ALSO SHOWN ON PLANS

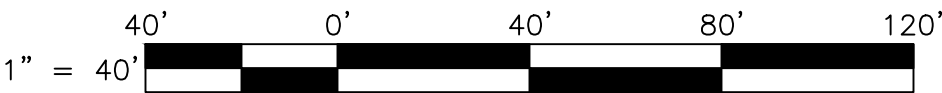

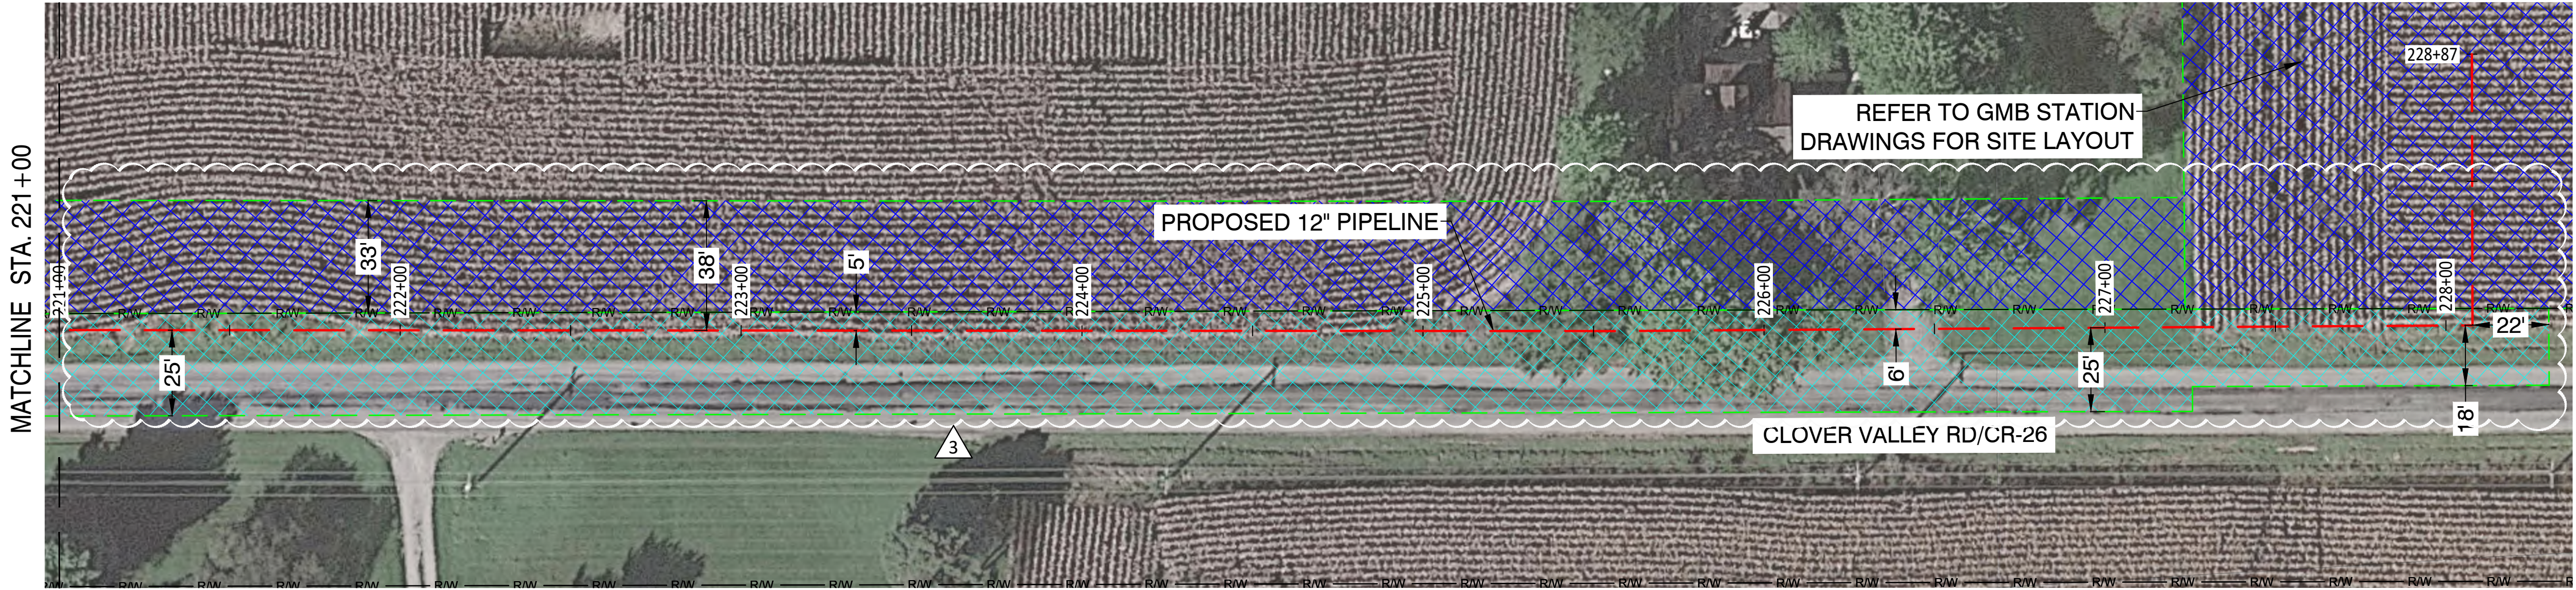

PROPOSED PLAN - 221+00 TO 228+87
(SCALE: 1" = 40')

- NOTES:
1. AERIAL IMAGERY IS FOR REFERENCE ONLY
 2. WORKSPACE WITHIN CLOVER VALLEY ROAD RIGHT-OF-WAY IS TO EXTEND FROM R.O.W. LINE TO EDGE OF PAVEMENT UNLESS NOTED OTHERWISE
 3. TEMPORARY WORKSPACE AND ADDITIONAL TEMPORARY WORKSPACE ON PRIVATE PROPERTY ARE ALSO SHOWN ON PLANS

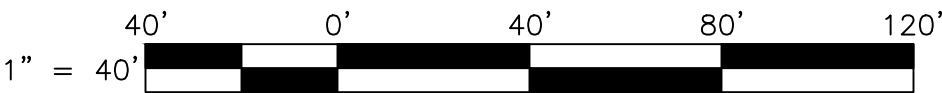

NiSource

Ohio Utilities Protection Service
Call 811
before you dig



7/7/2023

CAMPOS
EPC

200 W Adams, Suite 400, Chicago, IL 60606
(708) 505-5313

PROPOSED

REVISIONS			
REV. #	DATE	DESCRIPTION	
3	07/06/23	UPDATED FOR PROPOSED ROW	
2	06/09/23	REVISED FOR DOT COMMENT	
1	05/05/23	UPDATED INST#	
0	03/17/23	ISSUED FOR CONSTRUCTION	
DESIGNED BY	J. JORDAN	03/17/23	708-505-5313
DRAWN BY	A. McMICHAEL	03/17/23	708-505-5313
CHECKED BY	S. WACH	03/17/23	708-505-5313
AS-BUILT BY			
NAME		DATE	PHONE #

SITE NAME:
INST# 23-0083545-00 & 23-0083546-00
PROJECT ID# 21-85257
INTEL PROJECT SLICE
NEW ALBANY, LICKING COUNTY, OH

DRAWING TITLE:
EASEMENT & WORKSPACE
STA 221+00 TO STA 228+87

DRAWING NO:
L-111