
N

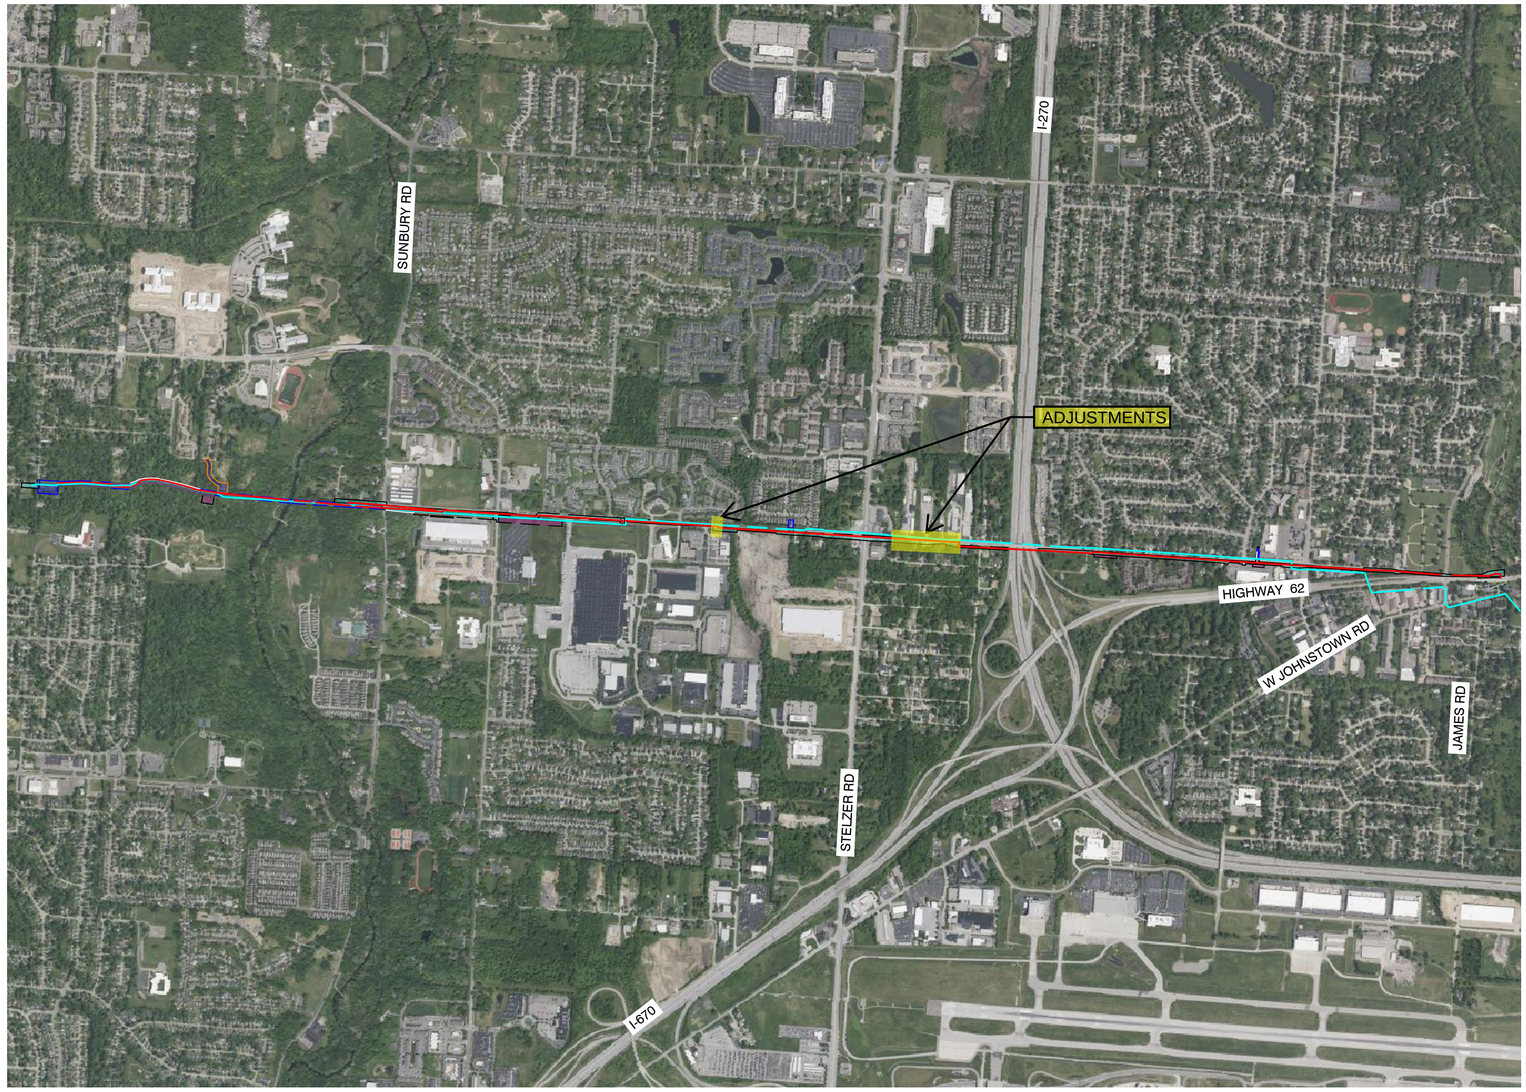

OVERVIEW SHEET INDEX

SCALE: 1"=1000'

NiSource

Ohio Utilities Protection Service
Call 811 before you dig

CAMPOS EPC
401 N Front St, Suite 380, Columbus, OH 43215
(380) 799-8503

PROPOSED

REVISIONS		
D	05/08/25	REVISED FOR 2027 CONSTRUCTION
C	06/18/25	REVISED FOR TEMP. TIE-IN
B	05/05/25	REVISED FOR CONSTRUCTION NOTICE
A	12/23/24	ISSUED FOR PERMIT
REV. #	DATE	DESCRIPTION

INTERNAL ENG.	AD	12/23/24	614-981-0661
DESIGNED BY	JMJ	12/23/24	855-266-7671
CHECKED BY	RBW	12/23/24	855-266-7671
AS-BUILT BY	TBD	TBD	TBD
	NAME	DATE	PHONE #

SITE NAME:

INST# 23-0083895-00
ABAN# 23-0083897-00
PROJECT ID# 21-78793

AGLER ROAD NCHP PIPELINE PROJECT
COLUMBUS/GAHANNA, FRANKLIN COUNTY, OH

DRAWING TITLE:

OVERVIEW WORKSPACE

DRAWING NO:

AG-01

2/9/2021 - 22 x 34